

PIKE  
B 80  
3-11-71

MISSISSIPPI  
BOARD OF WATER COMMISSIONERS  
416 North State Street  
Jackson, Mississippi 39201

**CODED**

WATER WELL DRILLERS LOG

11 March 1971 date well completed      S & P Waterwell firm name      Pike county well located

LANDOWNER:  
L. C. Smith  
Summit (mailing address)

WELL LOCATION:  
sec. 14 T. 4 N R. 8 E  
5 miles East of Summit (distance) (direction) (nearest town)

WELL PURPOSE:  
(home, irrigation, municipal, industrial)

- WELL COMPLETION DATA:
- (1) diameter (inches) 4
  - (2) total depth (feet) 135
  - (3) static water level (feet) 20 below top of ground.
  - (4) casing 11 (material), 129 (depth), (size) if telescope see back.
  - (5) screen 6 (length), 129 (depth to top), 1/2 (size), 11 (material)
  - (6) pump 1/2 (HP), 8 (yield gpm), Elect (type power)
  - (7) electric log (yes or no)
  - (organization running log)
  - (8) how well bottom plugged Wood

description of formations encountered	from	to
Clay	0	25
Chalk	25	35
Gravel	35	55
Chalk	55	90
Gravel	90	135

**CODED**


MAY 6 - 1971

DRILLERS REMARKS:

MISS. BD. OF  
WATER COMM.

If well telescopes please sketch and show depths.

GROUND LEVEL

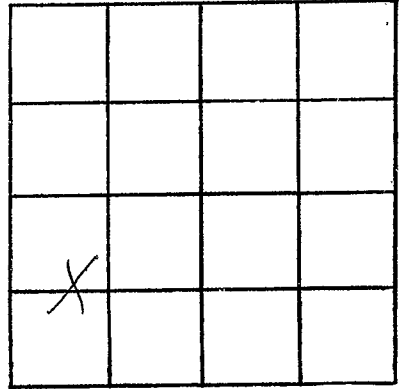

SECTION 14

Please indicate well location X.

ADDITIONAL INFORMATION

If more than one screen, show locations of each on sketch.