

PIKE
B 83
4-12-71

MISSISSIPPI
BOARD OF WATER COMMISSIONERS
416 North State Street
Jackson, Mississippi 39201

CODED

WATER/WELL DRILLERS LOG

April 12, 1971 *Chester Keenes* *Pike*
 Date well completed firm name county well located

LANDOWNER: *James Lewis*
AFD Summit
 (mailing address)

description of formations encountered	from	to
<i>red clay</i>	<i>0</i>	<i>17</i>
<i>red sand</i>	<i>17</i>	<i>57</i>
<i>white chalk</i>	<i>57</i>	<i>112</i>
<i>fine sand</i>	<i>112</i>	<i>130</i>
<i>coarse sand</i>	<i>130</i>	<i>141</i>

WELL LOCATION:
 sec. *B* T. *4* N R. *5* E
3 miles *WNE* of *Summit*
 (distance) (direction) (nearest town)
 WELL PURPOSE: *house*
 (home, irrigation, municipal, industrial)

WELL COMPLETION DATA:
 (1) diameter (inches) *18"*
 (2) total depth (feet) *141*
 (3) static water level (feet) *90* below top of ground.
 (4) casing *plast* *Bottom*
 (material) (depth)
 (size) if telescope see back.
 (5) screen *6"* *135*
 (length) (depth to top)
 (size) *plast*
 (material)
 (6) pump *pump by others*
 (HP) (yield gpm)
 (type power)
 (7) electric log *no*
 (yes or no)
 (organization running log)
 (8) how well bottom plugged *wading plug*

CODED


MAY 20 1971

DRILLERS REMARKS:
new location

MISS. DEPT. OF
 WATER CONTROL

If well telescopes please sketch and show depths.

GROUND LEVEL

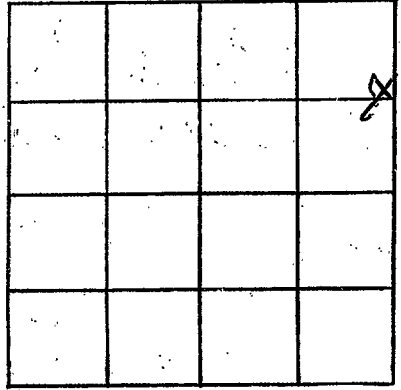

SECTION 13

Please indicate well location X.

ADDITIONAL INFORMATION

If more than one screen, show locations of each on sketch.