

PIKE
B85
5-31-71

MISSISSIPPI
BOARD OF WATER COMMISSIONERS
416 North State Street
Jackson, Mississippi 39201
WATER WELL DRILLERS LOG

CODED

31 May 1971 J.T. Covington Son Pike
date well completed firm name county well located

LANDOWNER:
J.M.J.C.
Summit
(mailing address)
WELL LOCATION:
sec. 19 T 4 N R 8 E
S W
2 miles E of Summit
(distance) (direction) (nearest town)

description of formations encountered	from	to
Clay	0	25
Chalk	25	35
Sand Chalk	35	50
Sand Rock	50	65
Chalk	65	160
Sand	160	189

WELL PURPOSE:
(home, irrigation, municipal, industrial)

WELL COMPLETION DATA:
(1) diameter (inches) 4
(2) total depth (feet) 189
(3) static water level (feet) 55 below top of ground.
(4) casing Plastic 159 (material) (depth)
(size) if telescope see back.
(5) screen 30 159 (length) (depth to top)
4 Plastic (size) (material)
(6) pump 5 70 (HP) (yield gpm)
elect (type power)
(7) electric log (yes or no)
(organization running log)
(8) how well bottom plugged wood

CODED


JUL 14 1971

MISSISSIPPI BOARD OF WATER COMMISSIONERS

DRILLERS REMARKS:

If well telescopes please sketch and show depths.

GROUND LEVEL

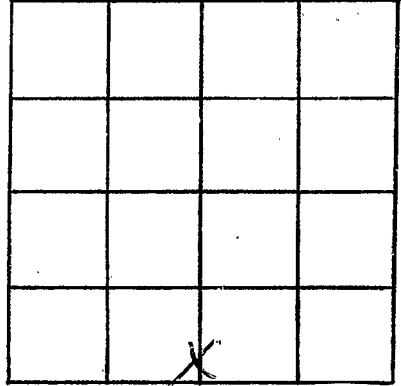

SECTION 19

Please indicate well location X.

ADDITIONAL INFORMATION

If more than one screen, show locations of each on sketch.