

Pike
B-86
8-17-71

MISSISSIPPI
BOARD OF WATER COMMISSIONERS
416 North State Street
Jackson, Mississippi 39201

WATER WELL DRILLERS LOG **CODED**

Aug 17 1971 chertokeene pike
date well completed firm name county well located

LANDOWNER: Ray Brewer

RT 1
McComb
(mailing address)

description of formations encountered

from to

Red sand & clay 0 27
gravel & sand 44 56
fine white sand & chert 50 90
blue & white chert 90 148
Coarse sand & small pebbles 148 170

WELL LOCATION:

sec. 35 T 4 N R 8 E
4 miles ENE of McComb
(distance) (direction) (nearest town)

WELL PURPOSE: domestic
(home, irrigation, municipal, industrial)

WELL COMPLETION DATA:

- (1) diameter (inches) 4"
- (2) total depth (feet) 170
- (3) static water level (feet) 72 below top of ground
- (4) casing (material) (depth) Plast. Bottom
- (5) screen (length) (depth to top) 160'
(size) (material) 1/2" Plast.
- (6) pump (HP) (yield gpm) 1 1/2 20
(type power) Elect.
- (7) electric log (yes or no) NO

(organization running log)

(8) how well bottom plugged working plug

DRILLERS REMARKS: New bore


CODED

SEP 17 1971

MISS. BD. OF
WATER COMMISSIONERS

If well telescopes please sketch and show depths.

GROUND LEVEL

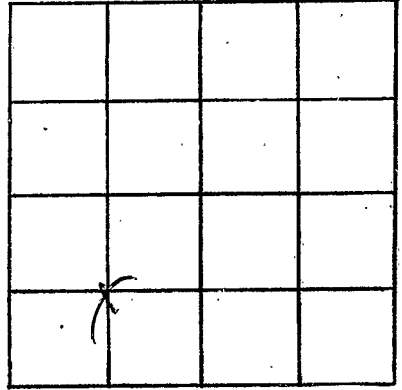

SECTION 35

Please indicate well location X.

ADDITIONAL INFORMATION

If more than one screen, show locations of each on sketch.