

MISSISSIPPI
BOARD OF WATER COMMISSIONERS
416 North State Street
Jackson, Mississippi 39201

DEC 6 1971

WATER WELL DRILLERS LOG

CODED

Pike
B87
10-28-71

28 Oct 1971 J. T. Cunningham Pike
date well completed firm name county well located

LANDOWNER:
Cecil Barley
Pricedale
(mailing address)

description of formations encountered	from	to
Clay	0	20
Gravelly	20	50
Back-s	50	106
Clay	106	180
Sand	180	190
Clay	190	210
Sand	210	225

WELL LOCATION:
sec. 12 T. 4 N. R. 8 E.
1/2 miles East of Pricedale
(distance) (direction) (nearest town)

WELL PURPOSE:
(home, irrigation, municipal, industrial)


- WELL COMPLETION DATA:
- (1) diameter (inches) 4
 - (2) total depth (feet) 225
 - (3) static water level (feet) 90 below above top of ground.
 - (4) casing PI 213
(material) (depth)
(size) if telescope see back.
 - (5) screen 12 213
(length) (depth to top)
4 PI
(size) (material)
 - (6) pump 1/2 8
(HP) (yield gpm)
Dist
(type power)
 - (7) electric log yes
(yes or no)
Geothermal Service
(organization running log) Jackson
 - (8) how well bottom plugged Wood

CODED

DRILLERS REMARKS:

If well telescopes please sketch and show depths.

GROUND LEVEL

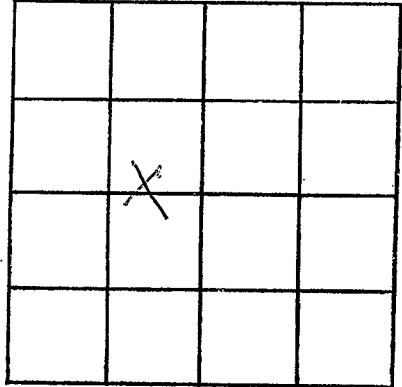

SECTION 13

Please indicate well location X.

ADDITIONAL INFORMATION

If more than one screen,
show locations of each on sketch.