

Pike
 088
 10-22-71

MISSISSIPPI
 BOARD OF WATER COMMISSIONERS
 416 North State Street
 Jackson, Mississippi 39201

CODED

WATER WELL DRILLERS LOG

10-22 date well completed 19 71 firm name *Flannell Well* Pike county well located

LANDOWNER:	description of formations encountered	from	to
<i>Hester Smith</i>			
<i>R.R. Summit Miss.</i> (mailing address)	<i>Red Sand</i>	<i>20</i>	<i>80</i>
WELL LOCATION:	<i>White Clay</i>	<i>80</i>	<i>120</i>
sec. <i>28</i> T. <i>4</i> N. R. <i>8</i> E	<i>Fine Sand</i>	<i>120</i>	<i>170</i>
<i>6</i> miles <i>T</i> of <i>Summit</i>	<i>Coarse Sand</i>	<i>170</i>	<i>182</i>
(distance) (direction) of (nearest town)			
WELL PURPOSE: <i>Home</i> (home, irrigation, municipal, industrial)			
WELL COMPLETION DATA:			
(1) diameter (inches) <i>4</i>			
(2) total depth (feet) <i>182</i>			
(3) static water level (feet) <i>95</i> below top of ground.			
(4) casing <i>Plastic, 176</i> (material) (depth)			
<i>4</i> (size) if telescope see back.			
(5) screen <i>6, 176</i> (length) (depth to top)			
<i>4, Plastic</i> (size) (material)			
(6) pump <i>1/2, 10</i> (HP) (yield gpm)			
<i>elec</i> (type power)			
(7) electric log <i>no</i> (yes or no)			
(organization running log)			
(8) how well bottom plugged <i>wood</i>			
DRILLERS REMARKS:			


CODED

OCT 26 1971

MISS. BD. OF
 WATER COMM.

If well telescopes please sketch and show depths.

GROUND LEVEL

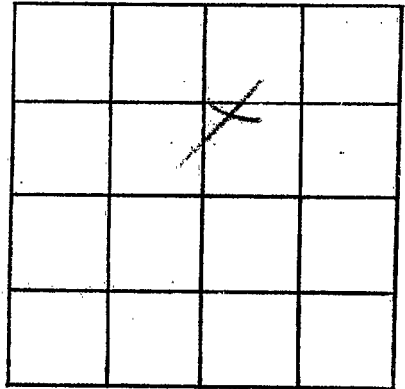

SECTION 28

Please indicate well location X.

ADDITIONAL INFORMATION

A series of horizontal lines for writing additional information, starting below the 'ADDITIONAL INFORMATION' header and extending down to the bottom of the page.

If more than one screen, show locations of each on sketch.