

Pike
B 90
2-19-72

MISSISSIPPI
BOARD OF WATER COMMISSIONERS
416 North State Street
Jackson, Mississippi 39201

CODED

WATER WELL DRILLERS LOG

Feb 19 1972 *chester keener* *Pike*
date well completed firm name county well located

LANDOWNER *Walter Brown*
CFD Summit
(mailing address)

description of formations encountered	from	to
<i>d/d clay</i>	<i>0</i>	<i>22</i>
<i>Red Sand</i>	<i>22</i>	<i>60</i>
<i>Red Sand Gravel</i>	<i>60</i>	<i>94</i>
<i>Red Chalky Sand</i>	<i>94</i>	<i>140</i>
<i>Coarse Sand & pea gravel</i>	<i>140</i>	<i>148</i>

WELL LOCATION:
sec. *3* T. *4* N. R. *5* E
5 miles *NE* of *Summit*
(distance) (direction) (nearest town)

WELL PURPOSE: *Drain*
(home, irrigation, municipal, industrial)

- WELL COMPLETION DATA:
- (1) diameter (inches) *4"*
 - (2) total depth (feet) *148*
 - (3) static water level (feet) *100* below top of ground.
 - (4) casing *Plast. Baltimore*
(material) (depth)
 - (size) if telescope see back.
 - (5) screen *6'* *142*
(length) (depth to top)
 - (size) *Plast.*
(material)
 - (6) pump *Weather-*
(HP) (yield gpm)
 - (type power) *skt*
 - (7) electric log *No*
(yes or no)
 - (organization running log)


CODED

(8) how well bottom plugged? *wooden plug*
DRILLERS REMARKS: *Newhaus*

MISS. BOARD OF WATER COMMISSIONERS

If well telescopes please sketch and show depths.

GROUND LEVEL

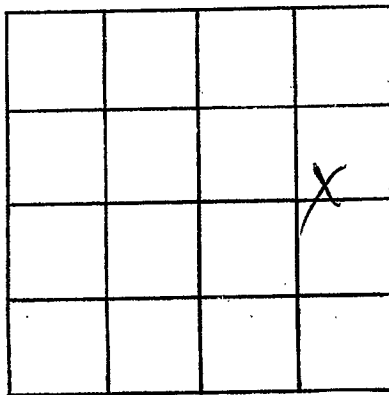

SECTION 3

Please indicate well location X.

ADDITIONAL INFORMATION

If more than one screen, show locations of each on sketch.