

MISSISSIPPI
BOARD OF WATER COMMISSIONERS
416 North State Street
Jackson, Mississippi 39201

CODED

WATER WELL DRILLERS LOG

Pike
B91
3-22-72

March 22 1972 Chester Keenes Pike
date well completed firm name county well located

LANDOWNER: Ralph Cliffs
At. Ruth
(mailing address)

WELL LOCATION:
sec. 13 T. 4 N. R. 4 E.
7 miles NE of Summit
(distance) (direction) (nearest town)

WELL PURPOSE: Home
(home, irrigation, municipal, industrial)

WELL COMPLETION DATA:

- (1) diameter (inches) 4"
- (2) total depth (feet) 135
- (3) static water level (feet) 82 below top of ground.
- (4) casing Plastic Ballam
(material) (depth)
- _____ If telescope see back.
(size)
- (5) screen 6' 129
(length) (depth to top)
- 4" Plastic
(size) (material)
- (6) pump 1/2 Sub 12
(HP) (yield gpm)
- Electric
(type power)
- (7) electric log NO
(yes or no)

(organization running log)

(8) how well is well plugged wooden plug

DRILLERS REMARKS: No. Reverse well.

description of formations encountered	from	to
clay	0	16
white sand yellow chalk	60	78
mixed sand and fine sand	78	112
coarse white sand	112	135


CODED

JUN 30 1972

MISS. Bd. OF
WATER COMMISSIONERS

If well telescopes please sketch and show depths.

GROUND LEVEL

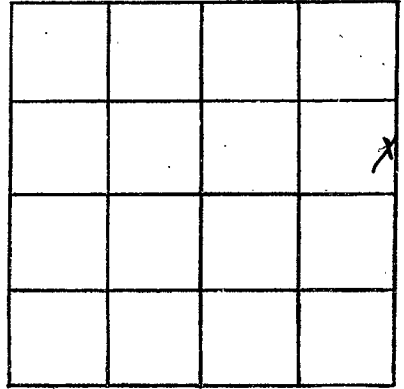

SECTION 13

Please indicate well location X.

ADDITIONAL INFORMATION

If more than one screen, show locations of each on sketch.