

MISSISSIPPI
BOARD OF WATER COMMISSIONERS
416 North State Street
Jackson, Mississippi 39201

CODED

Pike
B 93
2-13-73

WATER WELL DRILLERS LOG

2-13 1973 Fitzgerald well Co Pike
date well completed firm name county well located

LANDOWNER:

Von Beaul

RR 2 222 Comb
(mailing address)

description of formations encountered

from

to

<u>Red clay</u>	<u>0</u>	<u>10</u>
<u>white sand</u>	<u>10</u>	<u>45</u>
<u>Common sand & gravel</u>	<u>45</u>	<u>60</u>

WELL LOCATION:

sec. 35 T. 4 N. R. 8 E

5 miles E of Comb
(distance) (direction) (nearest town)

WELL PURPOSE:

Home
(home, irrigation, municipal, industrial)

WELL COMPLETION DATA:

(1) diameter (inches) 4
(2) total depth (feet) 60
(3) static water level (feet) 15 below above top of ground.

(4) casing plastic, 52
(material) (depth)

4 if telescope see back.
(size)

(5) screen 8, 52
(length) (depth to top)

4, plastic
(size) (material)

(6) pump 3/4, 20
(HP) (yield gpm)

elec
(type power)

(7) electric log ye
(yes or no)

(organization running log)

(8) how well bottom plugged wood plug


CODED

DRILLERS REMARKS:

FEB 27 1973

If well telescopes please sketch and show depths.

GROUND LEVEL

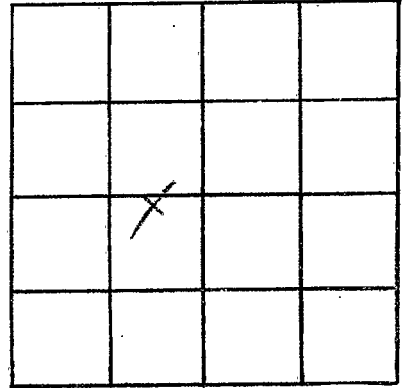

SECTION 35

Please indicate well location X.

ADDITIONAL INFORMATION

If more than one screen,
show locations of each on sketch.