

Pike
B94
1-4-73

MISSISSIPPI **CODED**
BOARD OF WATER COMMISSIONERS
416 North State Street
Jackson, Mississippi 39201

WATER WELL DRILLERS LOG

4 Jan 1973 date well completed
J.T. Campbell firm name
Pike county well located

LANDOWNER:
Ruby Crull
Summit
(mailing address)

| description of formations encountered | from | to |
|---------------------------------------|------|-----|
| Clay | 10 | 15 |
| Chalk clay | 15 | 35 |
| Red rock | 35 | 75 |
| Chalk | 75 | 120 |
| Sand | 120 | 172 |

WELL LOCATION:
sec. 29 T 4 N R 8 E
3 miles N.E. of Summit
(distance) (direction) (nearest town)

WELL PURPOSE:
(home, irrigation, municipal, industrial)


- WELL COMPLETION DATA:
- (1) diameter (inches) 4
 - (2) total depth (feet) 172
 - (3) static water level (feet) 110 below top of ground
 - (4) casing (material) PL (depth) 166
 - _____ if telescope see back. (size)
 - (5) screen (length) 6 (depth to top) 166
 - _____ (size) PL (material)
 - (6) pump (HP) K (yield gpm) 8
 - _____ (type power) Elect
 - (7) electric log _____ (yes or no)
 - _____ (organization running log)
 - (8) how well bottom plugged Good

CODED

DRILLERS REMARKS:

If well telescopes please sketch and show depths.

GROUND LEVEL

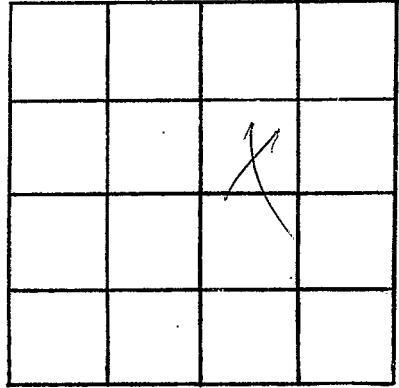

SECTION 28

Please indicate well location X.

ADDITIONAL INFORMATION

Lined area for additional information.

If more than one screen, show locations of each on sketch.