

Pike

B95

1-5-73

MISSISSIPPI  
 BOARD OF WATER COMMISSIONERS  
 416 North State Street  
 Jackson, Mississippi 39201

**CODED**

WATER WELL DRILLERS LOG

Jan 5 1973 Chester Reeves Pike  
 Date well completed firm name county well located

LANDOWNER: Juhan Loftin

Rt 1, Summit

(mailing address)

WELL LOCATION:

sec. 23T 4 N R 8 E  
5-6 miles PNE of Summit  
 (distance) (direction) (nearest town)

WELL PURPOSE: Home  
 (home, irrigation, municipal, industrial)

WELL COMPLETION DATA:

- (1) diameter (inches) 4"
- (2) total depth (feet) 109
- (3) static water level (feet)          below above top of ground.
- (4) casing (material) (depth)           
 (size) if telescope see back.
- (5) screen (length) (depth to top)           
 (size) (material)
- (6) pump (HP) (yield gpm)           
 (type power)
- (7) electric log (yes or no)           
 (organization running log)
- (8) how well bottom plugged

description of formations encountered

from

to

clay	0	14
Sand & gravel	14	26
white chalk	26	32
lobbly sand	32	46
Sand & gravel	46	57
Sand & rock	57	57
chalk	57	64
lobbly <b>CODED</b>	64	102
lean gravel	102	109

chalk next formation -


This well was cased with 4" plastic pipe - the water was salty, and the casing was pulled and another well drilled at another location -

DRILLERS REMARKS:

JAN 20 1973

If well telescopes please sketch and show depths.

GROUND LEVEL

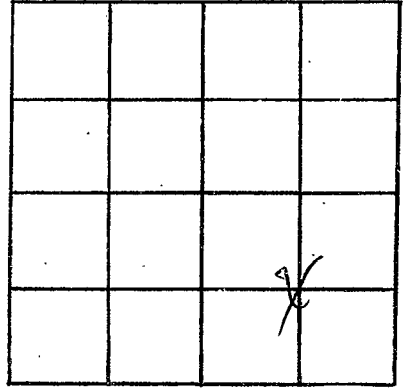

SECTION 23

Please indicate well location X.

ADDITIONAL INFORMATION

If more than one screen,  
show locations of each on sketch.