

MISSISSIPPI
 BOARD OF WATER COMMISSIONERS
 416 North State Street
 Jackson, Mississippi 39201

CODED

WATER WELL DRILLERS LOG

Pike
 B 96
 1-17-73

Jan 17 1973 Chesters Rees Pikes
 date well completed firm name county well located

LANDOWNER: Julian Lofton

description of formations encountered

from to

Rt 1 Summit -

clay & gravel

0 16

(mailing address)

gravel & sand

16 52

WELL LOCATION:

sec. 23 T. 4 N R. 8 E
 5-6 miles ENE of Summit
 (distance) (direction) (nearest town)

loam

52 88

WELL PURPOSE: Home
 (home, irrigation, municipal, industrial)

blue chalk

88 204

WELL COMPLETION DATA:

coarse white sand

204 268

(1) diameter (inches) 4"

(2) total depth (feet) 268

(3) static water level (feet) 35 below top of ground

(4) casing Plast Bottom (material) (depth)

(size) if telescope see back.

(5) screen 10' (length) 258' (depth to top)

CODED

(size) (material) 4" Plast

(6) pump 3/4 HP (HP) 15 (yield gpm)

(type power) elect

(7) electric log no (yes or no)

(organization running log)


(8) how well bottom plugged woodchips

DRILLERS REMARKS:

well at home salty - another salty well drilled Jan 5 - log and report mailed

If well telescopes please
sketch and show depths.

GROUND LEVEL

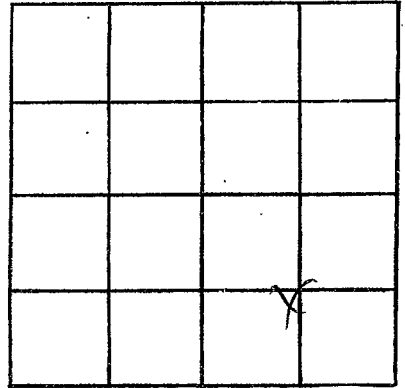

SECTION 23

Please indicate well location X.

ADDITIONAL INFORMATION

If more than one screen,
show locations of each on sketch.