

Pike  
B97  
3-5-73

MISSISSIPPI  
BOARD OF WATER COMMISSIONERS  
416 North State Street  
Jackson, Mississippi 39201

CODED

WATER WELL DRILLERS LOG

March 5 1973 Chester Keener Pike  
date well completed firm name county well located

LANDOWNER: Clyde Galman  
RFL  
Summit  
(mailing address)

description of formations encountered	from	to
Red clay	0	15
Red sand	15	04
Sand & gravel	14	59
Schaly	59	64
white shell	64	74
fine quartz sand	94	117
Coarse sand	117	160

WELL LOCATION:  
sec 33 T 4 N R 4 E  
2 1/2 miles ENE McComb  
(distance) (direction) (nearest town)

WELL PURPOSE: Home  
(home, irrigation, municipal, industrial)

- WELL COMPLETION DATA:
- (1) diameter (inches) 4"
  - (2) total depth (feet) 160
  - (3) static water level (feet) 54 below top of ground
  - (4) casing Plast Bottom  
(material) (depth)
  - (size) if telescope see back.
  - (5) screen 6' 154'  
(length) (depth to top)
  - 4" Plast  
(size) (material)
  - (6) pump 1/2 sub 12  
(HP) (yield gpm)
  - elect  
(type power)
  - (7) electric log No  
(yes or no)
  - (organization running log)


(8) how well bottom plugged  
wooden plug

DRILLERS REMARKS:  
old well had

1973  
MIS

If well telescopes please sketch and show depths.

GROUND LEVEL

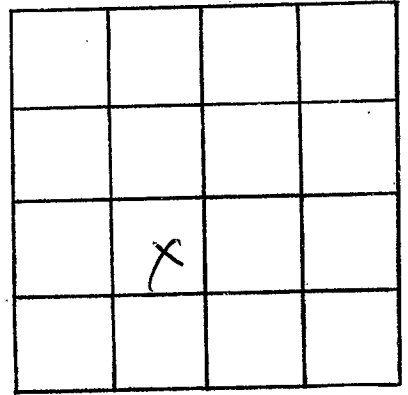

SECTION 33

Please indicate well location X.

ADDITIONAL INFORMATION

If more than one screen, show locations of each on sketch.