

Pike
B 98
4-30-73

MISSISSIPPI
BOARD OF WATER COMMISSIONERS
416 North State Street
Jackson, Mississippi 39201

CODED

WATER WELL DRILLERS LOG

4-30-1973 date well completed
Fitzgerald Well Serv firm name
Pike county well located

LANDOWNER:

Clara Bisby
R.R. Summit, Miss
(mailing address)

description of formations encountered

from to

grey + red clay	0	20
gravel	20	40
fine sand	40	64
coarse sand gravel	64	74

WELL LOCATION:

sec. 22 T. 4 N R. 8 E
6 miles E of Summit
(distance) (direction) (nearest town)

WELL PURPOSE: Home
(home, irrigation, municipal, industrial)

WELL COMPLETION DATA:

- (1) diameter (inches) 4
- (2) total depth (feet) 74
- (3) static water level (feet) 35 below top of ground.
- (4) casing plastic 66 (material) (depth)
4 (size) if telescope see back.
- (5) screen 8 66 (length) (depth to top)
4 (size) plastic (material)
- (6) pump 1/3 10 (HP) (yield gpm)
class (type power)
- (7) electric log no (yes or no)
(organization running log)
- (8) how well bottom plugged goodly


CODED

DRILLERS REMARKS:

MISSISSIPPI 6 1973

If well telescopes please sketch and show depths.

GROUND LEVEL

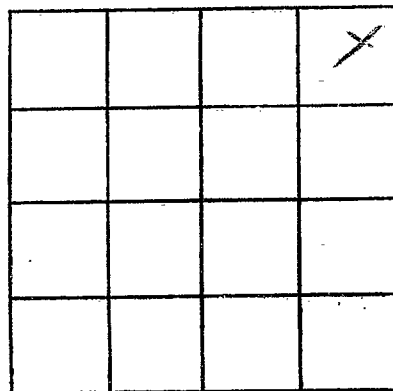

SECTION 22

Please indicate well location X.

ADDITIONAL INFORMATION

If more than one screen, show locations of each on sketch.