

Pike
B 99
4-4-73

MISSISSIPPI
BOARD OF WATER COMMISSIONERS
416 North State Street
Jackson, Mississippi 39201
WATER WELL DRILLERS LOG

CODED

4-4 date well completed 1973 Feb 24 firm name *Federal Well Dr* Pike county well located

LANDOWNER:
Jack Boggs
R.R. McComb Miss
(mailing address)

description of formations encountered	from	to
<i>Red clay</i>	<i>0</i>	<i>20</i>
<i>Red sand</i>	<i>20</i>	<i>60</i>
<i>Coarse sand & gravel</i>	<i>60</i>	<i>70</i>

WELL LOCATION:
sec *27* T-*4N* R-*8E*
5 miles *ENE* of *McComb*
(distance) (direction) (nearest town)

WELL PURPOSE:
Home
(home, irrigation, municipal, industrial)

WELL COMPLETION DATA:

(1) diameter (inches) *4*

(2) total depth (feet) *70*

(3) static water level (feet) *50* below top of ground.

(4) casing *plastic*, *62*,
(material) (depth)
4 if telescope see back.
(size)

(5) screen *8*, *62*
(length) (depth to top)
4, *plastic*
(size) (material)

(6) pump *1/2* *12*
(HP) (yield gpm)
elec
(type power)

(7) electric log *no*
(yes or no)
(organization running log)

(8) how well bottom plugged *6 3/4 inch pipe*


CODED

DRILLERS REMARKS:

MISSISSIPPI
BOARD OF WATER COMMISSIONERS
JAN 1973

If well telescopes please sketch and show depths.

GROUND LEVEL

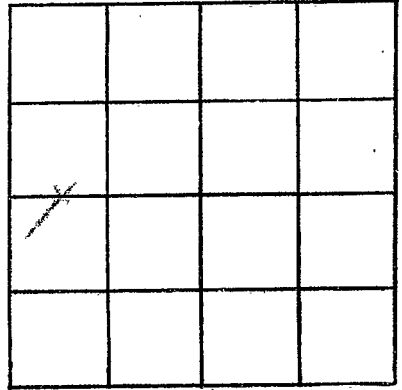

SECTION 27

Please indicate well location X.

ADDITIONAL INFORMATION

If more than one screen, show locations of each on sketch.