

CODED

B 100
PIKE
7-17-73

MISSISSIPPI
BOARD OF WATER COMMISSIONERS
416 North State Street
Jackson, Mississippi 39201


WATER WELL DRILLERS LOG

7-17 1973 *Flynn & Bell Co* *Pike*
date well completed firm name county well located

LANDOWNER:	description of formations encountered	from	to
<i>Annie L. Taylor</i>			
<i>Reh Summit Miss</i> (mailing address)	<i>Red Clay</i> <i>Red Sand</i> <i>White Chalky</i> <i>Green Sand</i>	<i>0</i> <i>20</i> <i>115</i> <i>170</i>	<i>20</i> <i>115</i> <i>170</i> <i>184</i>
WELL LOCATION: sec. <i>24</i> T. <i>4</i> (N) R. <i>8</i> (E) <i>4</i> miles <i>E</i> of <i>Summit</i> (distance) (direction) (nearest town)			
WELL PURPOSE: <i>dw</i> (home, irrigation, municipal, industrial)			
WELL COMPLETION DATA: <i>4</i>			
(1) diameter (inches)			
(2) total depth (feet) <i>184</i>			
(3) static water level (feet) <i>120</i> below top of ground.			
(4) casing <i>plastic 176</i> (material) (depth)			
<i>4</i> if telescope see back. (size)			
(5) screen <i>8</i> <i>176</i> (length) (depth to top)			
<i>4</i> <i>plastic</i> (size) (material)			
(6) pump <i>1/2</i> <i>10</i> (HP) (yield gpm)			
<i>elec</i> (type power)			
(7) electric log <i>yes</i> (yes or no)			
(organization running log)			
(8) how well bottom plugged <i>wood peg</i>			
DRILLERS REMARKS:	<i>AUG 15 1973</i>		

If well telescopes please sketch and show depths.

GROUND LEVEL

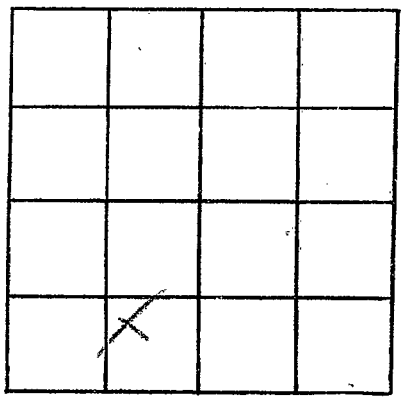

SECTION 34

Please indicate well location X.

ADDITIONAL INFORMATION

A series of horizontal lines for writing additional information, starting below the 'ADDITIONAL INFORMATION' header and extending to the bottom of the page.

If more than one screen, show locations of each on sketch.