

PIKE
B102
10-10-73

MISSISSIPPI
BOARD OF WATER COMMISSIONERS
416 North State Street
Jackson, Mississippi 39201

WATER WELL DRILLERS LOG

CODED

10-10
date well completed

1973 *Fitzgerald Well Service*
firm name

Pike
county well located

LANDOWNER:

Joe Jackson
RD McComb Miss.
(mailing address)

description of formations encountered

from to

<i>red clay</i>	0	20
<i>red gravel</i>	30	80
<i>red clay</i>	80	140
<i>concrete</i>	140	152

WELL LOCATION:

sec. 11 T 4 N R. 8 E
5 miles E of McComb
(distance) (direction) (nearest town)

WELL PURPOSE:

Home
(home, irrigation, municipal, industrial)

WELL COMPLETION DATA:

- diameter (inches) 4
- total depth (feet) 152
- static water level (feet) 70 below top of ground.
- casing plastic, 144,
(material) (depth)
4 If telescope see back.
(size)
- screen 8, 144
(length) (depth to top)
4, plastic
(size) (material)
- pump 1/2, 10
(HP) (yield gpm)
Electric
(type power)
- electric log Y
(yes or no)
(organization running log)
- how well bottom plugged Wood plug

CODED


DRILLERS REMARKS:

NOV 15 1973

MISS. Bd. OF
WATER COM.

If well telescopes please sketch and show depths.

GROUND LEVEL

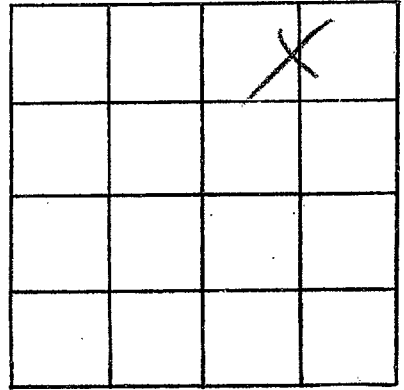

SECTION 11

Please indicate well location X.

ADDITIONAL INFORMATION

If more than one screen,
show locations of each on sketch.