

PIKE
B103
1-22-74

MISSISSIPPI
BOARD OF WATER COMMISSIONERS
416 North State Street
Jackson, Mississippi 39201

CODED

WATER WELL DRILLERS LOG

1-22-74 date well completed 1974 Filzgerald wells firm name Pike county well located

LANDOWNER:

Earl Broun
P.R. Summit Miss.
(mailing address)

description of formations encountered

description of formations encountered	from	to
red clay	0	20
red sand	20	60
coarse sand & gravel	60	75

WELL LOCATION:

sec 29 T 4 N R 8 E
3 miles E of Summit
(distance) (direction) (nearest town)

WELL PURPOSE:

Home (home, irrigation, municipal, industrial)

WELL COMPLETION DATA:

- (1) diameter (inches) 4
- (2) total depth (feet) 75
- (3) static water level (feet) 3.5 below top of ground.
- (4) casing plastic 67 (material) (depth)
4 (size) if telescope see back.
- (5) screen 8 67 (length) (depth to top)
4 plastic (size) (material)
- (6) pump 1/2 10 (HP) (yield gpm)
Elex (type power)
- (7) electric log No (yes or no)
(organization running log)
- (8) how well bottom plugged bedrock


CODED

DRILLERS REMARKS:

FEB 25 1974

If well telescopes please sketch and show depths.

GROUND LEVEL

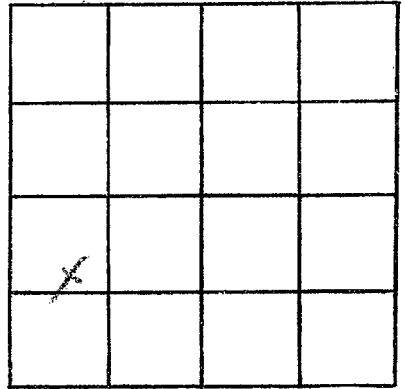

SECTION 29

Please indicate well location X.

ADDITIONAL INFORMATION

If more than one screen,
show locations of each on sketch.