

PIKE
B106
11-7-73

MISSISSIPPI
BOARD OF WATER COMMISSIONERS
416 North State Street
Jackson, Mississippi 39201 **CODED**

WATER WELL DRILLERS LOG

NOV 7 1973 Chester Keener Pike
date well completed firm name county well located

LANDOWNER: Robert Brown
RFD 5 Rutledge

| description of formations encountered | from | to |
|---------------------------------------|------|-----|
| Red clay | 0 | 22 |
| fine sand of chalk | 22 | 85 |
| Medium coarse sand | 85 | 100 |

(mailing address)

WELL LOCATION:
sec. 14 T. 4 N R. 8 E
5.5 miles NE of Summit
(distance) (direction) (nearest town)

WELL PURPOSE: Home
(home, irrigation, municipal, industrial)

CODED


WELL COMPLETION DATA:

- (1) diameter (inches) 4"
- (2) total depth (feet) 100
- (3) static water level (feet) 44 below/above top of ground.
- (4) casing Plast Bittum
(material) (depth)
- (size) if telescope see back.
- (5) screen 6' 94'
(length) (depth to top)
4" Plast
(size) (material)
- (6) pump 1/2 Sub 15
(HP) (yield gpm)
Plast
(type power)
- (7) electric log no
(yes or no)

(organization running log)

(8) how well bottom plugged
wooden plug

DRILLERS REMARKS:
new bore

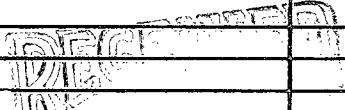


NOV 24 1973

MISS. BD. OF WATER COM.

If well telescopes please sketch and show depths.

GROUND LEVEL

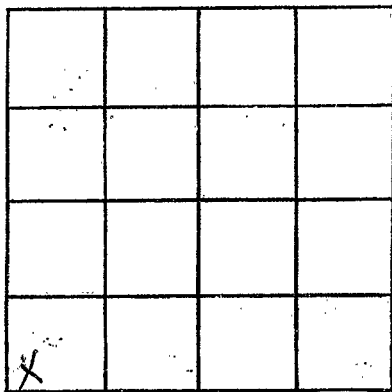

SECTION 14

Please indicate well location X.

ADDITIONAL INFORMATION

If more than one screen, show locations of each on sketch.