

PIKE
 B 107
 5-7-74

MISSISSIPPI
 BOARD OF WATER COMMISSIONERS
 416 North State Street
 Jackson, Mississippi 39201

CODED

WATER WELL DRILLERS LOG

5/7/74 19
 date well completed

J. T. Carney & Son
 firm name

Pike
 county well located

LANDOWNER: Elmer Soroka

description of formations encountered

from	to
0	20
20	40
40	60
60	80

Red clay
 Sand & Gravel
 Sand & Gravel
 Sand

Summit Miss
 (mailing address)

WELL LOCATION:

sec 26 T 4 N R 8 E
6 miles East of Summit
 (distance) (direction) (nearest town)

WELL PURPOSE:

(home, irrigation, municipal, industrial)

WELL COMPLETION DATA:

- (1) diameter (inches) 4"
- (2) total depth (feet) 80
- (3) static water level (feet) 20 below top of ground.
- (4) casing PI, 84 (material), (depth)
 (size) if telescope see back.
- (5) screen 6, 84 (length), (depth to top)
4, PI (size), (material)
- (6) pump 1/2, 8 (HP), (yield gpm)
Electric (type power)
- (7) electric log _____ (yes or no)
 (organization running log)
- (8) how well bottom plugged wood

CODED

RECEIVED


JUL 11 1974

DRILLERS REMARKS:

MISS. BD. OF WATER COMM

If well telescopes please sketch and show depths.

GROUND LEVEL

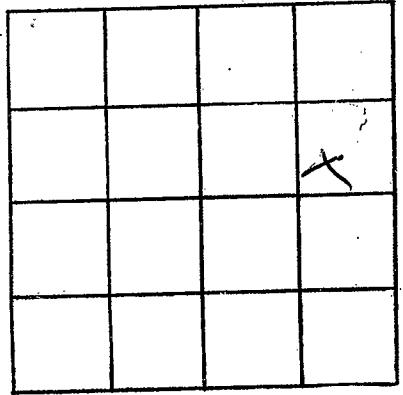

SECTION 26

Please indicate well location X.

ADDITIONAL INFORMATION

Lined area for additional information.

If more than one screen, show locations of each on sketch.