

PIKE
B108
9-25-74

MISSISSIPPI
BOARD OF WATER COMMISSIONERS
416 North State Street
Jackson, Mississippi 39201

CODED

WATER WELL DRILLERS LOG

Sept 25 1974 date well completed
Chester Keener firm name
Pike county well located

LANDOWNER: William Patterson
172 Ruth
(mailing address)

WELL LOCATION:
sec. 13 T 4 N R 4 E
7 miles NE of Summit
(distance) (direction) (nearest town)

WELL PURPOSE: farm
(home, irrigation, municipal, industrial)

WELL COMPLETION DATA:
(1) diameter (inches) 4"
(2) total depth (feet) 143
(3) static water level (feet) 92 below top of ground.
(4) casing cast iron (material) Patterson (depth)
(size) If telescope see back.
(5) screen 6" (length) 137 (depth to top)
4" (size) blast (material)
(6) pump 1/2 sub 12 (HP) (yield gpm)
blast (type power)
(7) electric log no (yes or no)
(organization running log)

description of formations encountered	from	to
clay	0	18
Red sand	18	62
Sand & gravel	62	94
sand	94	95
chall. silt clay	95	128
crossed with gravel	128	143

(8) how well bottom plugged
wood chips
DRILLERS REMARKS:
old well had


RECEIVED

OCT 30 1974

MISS. BD. OF WATER COMMISSIONERS

If well telescopes please sketch and show depths.

GROUND LEVEL

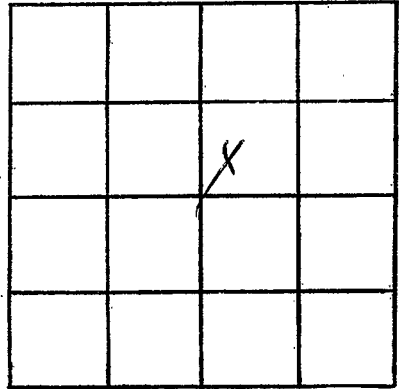

SECTION 13

Please indicate well location X.

ADDITIONAL INFORMATION

If more than one screen,
show locations of each on sketch.