

PIKE

B-44 B110

6-5-77

MISSISSIPPI
BOARD OF WATER COMMISSIONERS
416 North State Street
Jackson, Mississippi 39201

CODED

WATER WELL DRILLERS LOG

June 5 1977 Chester Kerner

Riba

date well completed

firm name

county well located

LANDOWNER:

Friendship

Baptist Church

Rt 2, McComb

(mailing address)

description of formations encountered

from

to

Red sandy clay

0 15-

yellow sand

15- 45-

White Chalk

45 50

Brown gravel

50 65-

Coarse sand

65 80

WELL LOCATION:

sec. 35 T 4 N R 8 E

1/2 miles E of McComb
(distance) (direction) (nearest town)

WELL PURPOSE:

church

(home, irrigation, municipal, industrial)

WELL COMPLETION DATA:

- (1) diameter (inches) 6"
(2) total depth (feet) 80
(3) static water level (feet) _____ below
top of ground. above

- (4) casing 12" galv. steel
(material) (depth)

(size) if telescope see back.

- (5) screen 6" 74"
(length) (depth to top)

4" galv. steel
(size) (material)

- (6) pump 1/2 HP 15
(HP) (yield gpm)

split
(type power)

- (7) electric log NO
(yes or no)


(organization running log)

- (8) how well bottom plugged
wood plug

DRILLERS REMARKS:

New Building

CODED

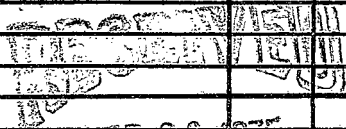


FEB 26 1977

MISS. BD. OF WATER COMMISSIONERS

If well telescopes please
sketch and show depths.

GROUND LEVEL

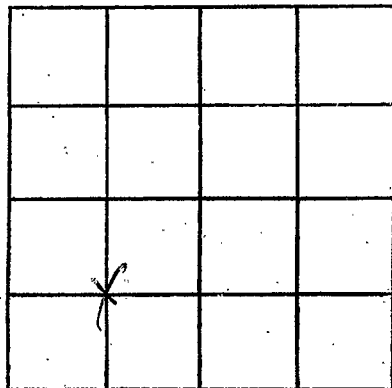

SECTION 35

Please indicate well location X.

ADDITIONAL INFORMATION

If more than one screen,
show locations of each on sketch.