

CODED

PIKE  
B III  
4-9-75

MISSISSIPPI  
BOARD OF WATER COMMISSIONERS  
416 North State Street  
Jackson, Mississippi 39201

WATER WELL DRILLERS LOG

*Pike  
London*

april 9 1975 *Chisto Pinner* county well located

LANDOWNER:  
*Gene Morgan*  
*Rt. Bogue Chitto*  
(mailing address)

description of formations encountered  
from to  
*Clay*  
*loam & gravel* 0.8 9.82

WELL LOCATION:  
sec. 1 T. 4 N R. 8 E  
7 miles N-NE of Summit  
(distance) (direction) (nearest town)

WELL PURPOSE: home  
(home, irrigation, municipal, industrial)

- WELL COMPLETION DATA:
- (1) diameter (inches) 4"
  - (2) total depth (feet) 82
  - (3) static water level (feet) 8 below top of ground.
  - (4) casing plastic, bottom  
(material) (depth)
  - no if telescope see back.  
(size)
  - (5) screen 6 76"  
(length) (depth to top)
  - 4" plastic  
(size) (material)
  - (6) pump Raytech  
(HPY) (yield gpm)
  - elect  
(type power)
  - (7) electric log no  
(yes or no)
- (organization running log)
- (8) how well bottom plugged wood plug


DRILLERS REMARKS:  
new test site

RECEIVED  
MAY - 8 1975

MISS. BD. OF WATER COMMISSIONERS

If well telescopes please sketch and show depths.

GROUND LEVEL

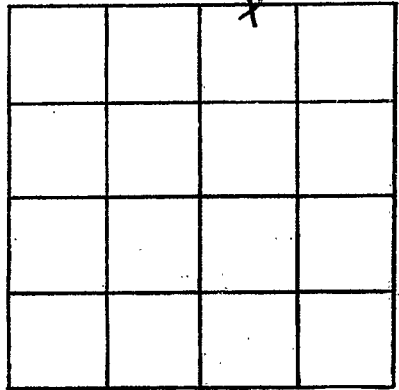

SECTION X

Please indicate well location X.

ADDITIONAL INFORMATION

If more than one screen, show locations of each on sketch.