

Pike
B-113
8-7-80

MISSISSIPPI
 BOARD OF WATER COMMISSIONERS
 416 North State Street
 Jackson, Mississippi 39201

CODED

WATER WELL DRILLERS LOG

Pike
~~Lincoln~~
 county well located

8-7 1980 El General Well Co. firm name
 date well completed

LANDOWNER:
Van D. McCallough
R.R. Boone Chitto
 (mailing address)

description of formations encountered	from	to
<u>Red clay</u>	<u>0</u>	<u>20</u>
<u>Red sand</u>	<u>50</u>	<u>80</u>
<u>Coarse sandstone</u>	<u>80</u>	<u>100</u>

WELL LOCATION:
 sec. 1 T 4 N R 8 E
1 miles W of Shubert
 (distance) (direction) (nearest town)

WELL PURPOSE:
Home
 (home, irrigation, municipal, industrial)

- WELL COMPLETION DATA:
- (1) diameter (inches) 4
 - (2) total depth (feet) 100
 - (3) static water level (feet) 55 below top of ground.
 - (4) casing PVC, 92,
 (material) (depth)
4 if telescope see back.
 (size)
 - (5) screen 8, 92
 (length) (depth to top)
4, PVC
 (size) (material)
 - (6) pump 1/2, 10
 (HP) (yield gpm)
Elm
 (type power)
 - (7) electric log no
 (yes or no)
Elm
 (organization running log)
 - (8) how well bottom plugged full block

DRILLERS REMARKS:


DEPT. OF NATURAL RESOURCES
 BUREAU OF LAND & WATER RESOURCES

SEP 8 1980

RECEIVED

If well telescopes please sketch and show depths.

GROUND LEVEL

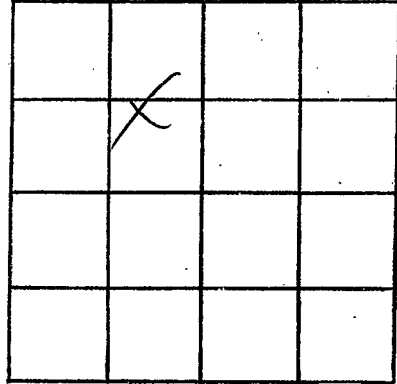

SECTION 1

Please indicate well location X.

ADDITIONAL INFORMATION

If more than one screen, show locations of each on sketch.