

Pike
 A184 B114
 1981

MISSISSIPPI
 BOARD OF WATER COMMISSIONERS
 416 North State Street
 Jackson, Mississippi 39201

CODED

WATER WELL DRILLERS LOG

date well completed 19 Jan 20 1981 firm name J. L. L. Drilling county well located Jackson

LANDOWNER:

James O. Oldham

4' water well
 (mailing address)

WELL LOCATION:

sec 8 T 4 N R 8 E
5 miles NW of McClure
 (distance) (direction) (nearest town)

WELL PURPOSE:

(home, irrigation, municipal, industrial)

WELL COMPLETION DATA:

- (1) diameter (inches) 4"
- (2) total depth (feet) 234
- (3) static water level (feet) 220 below top of ground.
- (4) casing Steel, 234
 (material) (depth)
- 0 if telescope see back.
 (size)
- (5) screen 40, 234
 (length) (depth to top)
- 4", ST.
 (size) (material)
- (6) pump air, 60
 (HP) (yield gpm)
- NA
 (type power)
- (7) electric log NA
 (yes or no)
- (organization running log)
- (8) how well bottom plugged ply

description of formations encountered	from	to
<u>hard red ground</u>	<u>0</u>	<u>60</u>
<u>clay</u>	<u>60</u>	<u>170</u>
<u>hard</u>	<u>170</u>	<u>220</u>
<u>red silty</u>	<u>220</u>	
<u>air blub.</u>	<u>184</u>	
<u>J. L. L. Drilling</u>		
<u>W. P. M.</u>	<u>95</u>	
<u>water in ground</u>	<u>234</u>	

920' N + 800' W of SE Cor.

CODED

DEPT. OF NATURAL RESOURCES
 BUREAU OF LAND & WATER RESOURCES


OCT 20 1981

RECEIVED

DRILLERS REMARKS:

If well telescopes please sketch and show depths.

GROUND LEVEL

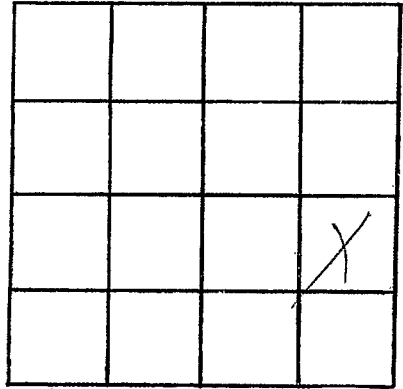

SECTION 8

Please indicate well location X.

ADDITIONAL INFORMATION

If more than one screen, show locations of each on sketch.