

MISSISSIPPI DEPARTMENT OF NATURAL RESOURCES

Bureau of Land and Water Resources

Southport Mall

P.O. Box 10631

Jackson, Mississippi 39209

WATER WELL DRILLERS LOG

COPIED

PIKE
B 119
11/9/80

Nov. 9 19*80*
date well completed

Newsall Son
firm name

Pike
county well located

LANDOWNER:

David Ard
Rt Summit
(mailing address)

description of formations encountered

from to

<i>Clay</i>	<i>0</i>	<i>27</i>
<i>Red sand</i>	<i>27</i>	<i>55</i>
<i>Gravel</i>	<i>55</i>	<i>61</i>
<i>loosely clay</i>	<i>61</i>	<i>102</i>
<i>sand & gravel</i>	<i>102</i>	<i>111</i>

WELL LOCATION:

sec. *10* T *4* N R *8* E
7 miles *ENE* of *Summit*
(distance) (direction) (nearest town)

WELL PURPOSE:

home
(home, irrigation, municipal, industrial)


WELL COMPLETION DATA:

- (1) diameter (inches) *4"*
- (2) total depth (feet) *111*
- (3) static water level (feet) *100* below top of ground
- (4) casing *plastic bottom*
(material) (depth)
- (5) screen *5'* *106'*
(length) (depth to top)
- (6) pump *4"* *plastic*
(size) (material)
- (7) pump *1/2* *10*
(HP) (yield gpm)
- (8) electric log *no*
(yes or no)

(organization running log)


(8) how well bottom plugged *back wash*

DRILLERS REMARKS:

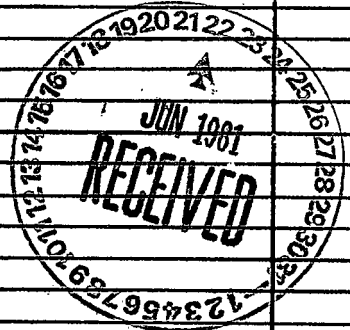

If well telescopes please sketch and show depths.

GROUND LEVEL

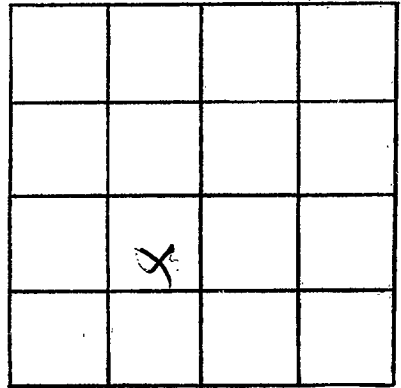

SECTION 10

Please indicate well location X.

ADDITIONAL INFORMATION

If more than one screen,
show locations of each on sketch.