

MISSISSIPPI DEPARTMENT OF NATURAL RESOURCES

Bureau of Land and Water Resources

Southport Mall

P.O. Box 10631

Jackson, Mississippi 39209

WATER WELL DRILLERS LOG

CODED

PIKE
B 135
4185

April 19 85 GRINER DRILLING CO. PIKE
date well completed firm name county well located

LANDOWNER: SHELL WESTERN EXP, WELL NO. 1	description of formations encountered	from	to
	TOP SOIL	0	3
	SAND + PEA GRAVEL	3	180
	CLAY	180	394
	SAND + CLAY STREAMS	394	412
	SAND	412	460
	SAND + CLAY STREAMS	460	492
	CLAY	492	505

(mailing address)
WELL LOCATION: NEAR NEAR NW
sec. 2 T. 4N S. R. 8 E
miles (distance) of (direction) (nearest town)

WELL PURPOSE: (home, irrigation, municipal, industrial)

WELL COMPLETION DATA:
(1) diameter (inches) 10 3/4
(2) total depth (feet) 443
(3) static water level (feet) 124.34 below top of ground.
(4) casing steel 407 (material), (depth)
10 3/4 (size) if telescope see back.
(5) screen 20 42.3 (length), (depth to top)
6" 304 S.S. (.016) (size), (material)
(6) pump 10 100 (HP), (yield gpm)
ELECT (type power)
(7) electric log Yes (yes or no)
(organization running log)

(8) how well bottom plugged Back
WELL DRILLER: ST & SONS

DRILLERS REMARKS:


CODED

RECEIVED
JUL 16 1985

Department of Natural Resources
Bureau of Land & Water Resources

If well telescopes please sketch and show depths.

GROUND LEVEL

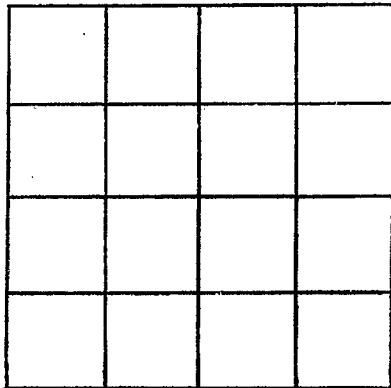

SECTION _____

Please indicate well location X.

ADDITIONAL INFORMATION

If more than one screen, show locations of each on sketch.