

MISSISSIPPI DEPARTMENT OF NATURAL RESOURCES
 Bureau of Land and Water Resources
 Southport Mall
 P.O. Box 10631
 Jackson, Mississippi 39209
WATER WELL DRILLERS LOG

PIKE
B138

CODED

605/86 19 Tom Griggs Well Service Pike, MS
 date well completed firm name county well located

LANDOWNER: <u>Murco Drlg Co</u>	description of formations encountered	from	to
<u>1900 Beck Building</u>			
<u>Shreveport, La 71101</u> (mailing address)	<u>CLAY</u>	<u>0</u>	<u>10</u>
	<u>Sand + Pea Gravel</u>	<u>10</u>	<u>200</u>

WELL LOCATION:
 sec 24 T 4 N R 5 E
 S W
5 miles E of McComb, Ms
 (distance) (direction) (nearest town)


Rayford Bennis
#1

WELL PURPOSE: Oil Location
 (home, irrigation, municipal, industrial)

WELL COMPLETION DATA:

- (1) diameter (inches) 3"
- (2) total depth (feet) 200'
- (3) static water level (feet) 30' below above top of ground.
- (4) casing PVC 160'
 (material) (depth)
N/A if telescope see back.
 (size)
- (5) screen 40 160'
 (length) (depth to top)
3" PVC
 (size) (material)
- (6) pump ATV 90
 (HP) (yield gpm)
Diesel
 (type power)
- (7) electric log No
 (yes or no)
N/A
 (organization running log)
- (8) how well bottom plugged BWV

CODED

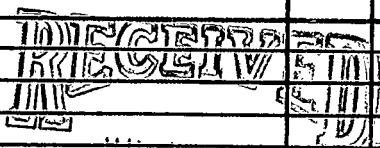

JUL 14 1986

DRILLERS REMARKS:

Department of Natural Resources
 Bureau of Land & Water Resources

