

**MISSISSIPPI DEPARTMENT OF ENVIRONMENTAL QUALITY**  
Bureau of Land and Water Resources

P. O. Box 10631  
Jackson, MS 39289-0631  
**WATER WELL DRILLERS LOG**

COUNTY WELL LOCATED <u>Pike</u>	
WELL NUMBER <u>B 141</u>	CODED <input checked="" type="checkbox"/>
DATE WELL COMPLETED <u>9/19/89</u>	

PERMIT NUMBER
NAME OF DRILLING FIRM <u>Griner Drilling</u>

NAME & MAILING ADDRESS OF LANDOWNER <u>Sanderson Farms, Inc.</u>		
<u>P.O. Box 988</u>		
<u>Laurel, MS 39441</u>		
WELL LOCATION: SEC	TOWNSHIP	RANGE
<u>26</u>	<u>4</u>	<u>8</u>
	<u>N</u>	<u>E</u>
	<u>S</u>	<u>W</u>
DISTANCE <u>3</u> Miles	DIRECTION <u>NE</u>	NEAREST TOWN <u>McComb</u>
OTHER LANDMARK <u>int. of Hwy 44 + Bogue Chitto River</u>		
WELL PURPOSE: Home, Irrigation, Municipal, Industrial, Fish Pond, etc. <u>Observation</u>		

PUMP DATA		
PUMP TYPE (Circle One): Submersible, Turbine, Jet, Flowing Well, Other (Describe) <u>None</u>		
POWER TYPE (Circle One): Electric, Tractor, Diesel, Gasoline, Butane, Other (Describe) <u>H/P</u>		
Pump Capacity (GPM)	No. of Stages	Setting Depth
		FT.
PUMP TEST		
Well yielded <u>7.5</u>	GPM with	
a drawdown of <u>54.57</u>	ft.	
after <u>9</u>	hours of pumping	

WELL DATA		
Well Depth <u>200</u>	Casing Diameter (In.) <u>4</u>	Casing Length (Ft.) <u>160</u>
Type of Casing: <u>PVC</u>	Hole Depth <u>652</u>	Depth to Static Water Level <u>64.93</u>
TYPE OF COMPLETION: (Circle One or More): Gravel Packed, Underreamed, Telescoped, <u>Natural Development</u> , Open Hole, Other		
Top of Lap Pipe or Reduction in Casing		
FEET		
IF TELESCOPED OR MORE THAN ONE SCREEN: USE BACK PAGE		

LOG DATA	
TYPE OF LOG RUN (Circle One): <u>Electric, Gamma Ray</u> , No Log Run, Density, Sonic, Neutron, Other (Describe)	
Name of Organization Running Log <u>Griner Drilling</u>	


SCREEN DATA		
Diameter - Inches <u>4</u>	Length - Feet <u>40</u>	Slot Size - Inches <u>.010</u>
Screen Type <u>Sawed PVC</u>	Depth to Bottom - Feet <u>200</u>	

GEOLOGIC DATA (Office Use Only)			
Surface Elev.	Geologic Unit	Unit Thickness	Depth to Top
Subs. SWL	Date	Analysis	Aquifer Test
Driller's Remarks <u>Originally registered in 1989</u> <u>Test well #1</u>			

DESCRIPTION OF FORMATIONS ENCOUNTERED	FROM TO		FORMATIONS (Continued)	FROM TO
	FROM	TO		
Top Soil	0	2	<div style="border: 2px solid black; padding: 10px; display: inline-block;"> <b>RECEIVED</b>   <b>MAY 27 1993</b>                       Dept. of Environmental Quality                      Office of Land &amp; Water Resources                 </div>	
Clay	2	10		
Sand + Pea Gravel	10	95		
Hard Rocks	95	105		
Sand + Pea Gravel	105	200		
Clay	200	390		
Sand	390	400		
Clay	400	530		
Sand	530	540		
Clay	540	652		
IF MORE SPACE IS NEEDED, USE BACK				

If well telescopes please  
sketch and show depths.

GROUND LEVEL

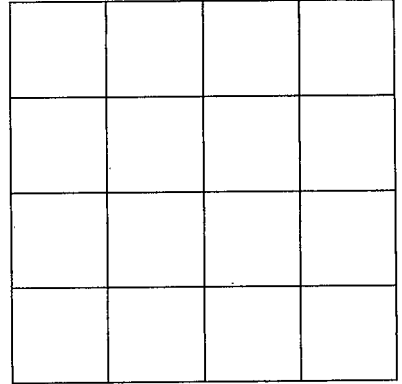

SECTION \_\_\_\_\_

Please indicate well location X.

ADDITIONAL INFORMATION

If more than one screen,  
show location of each on sketch.