

Part 2 never received 4/13

County: Pike
Permit #: _____
Driller: Fitzgerald Well Service
Date drilling completed: 6-7-07

State Well Report
Part 1 - Driller's Log
Mississippi Department of Environmental Quality
Office of Land and Water Resources
P.O. Box 10631
Jackson, MS 39289-0631
(601)961-5210
(601)354-6938 (fax)

For Office Use Only:
Aquifer: _____
Well #: B-189
L. S. Elevation: _____
E-log #: _____

State Law requires that this report be prepared by the licensee holder responsible for the work and filed with the Department at the above address within 30 days of completion of drilling of the well or borehole.

Information on Well Owner (Landowner if borehole is not for a water well)	Well or Borehole Location
Owner Name: <u>Jeremy Bond</u>	Latitude: <u>31° 15' 49.8"</u> Longitude: <u>90° 26' 8"</u>
Mailing Address: <u>Brewer Lane</u>	Method of Lat/Long (circle one): Conventional Survey
<u>Summit</u> <u>ms</u>	USGS quad, Hand-held GPS, Survey-grade GPS
City State Zip Code	<u>SE 1/4 Sec 31</u> <u>4N</u> <u>8E</u>
Telephone No. ()	Distance _____ Miles Direction _____ of _____

Well / Borehole Data

Date drilling started: 6-7-07 Date drilling completed: 6-7-07 Hole depth: 70' Hole diameter: 2"

Location of the source of any surface water used for drilling: _____
Method of dosing and volume of Chlorine used in drilling and development: _____

Logs run (circle all applicable): No log run Electric Gamma Ray Density Sonic Neutron Other: _____
Name of organization running log(s): _____

Purpose of borehole (check one): Water Well ☒ Geotechnical/Geological Investigation _____ Ground Source Heat Pump _____
Seismic Survey _____ Other (describe): _____

If drilling is not related to water well construction, skip the remainder of this block

Purpose of Well (check one): Home ☒ Industrial _____ Public Supply _____ Irrigation _____ Fish Culture _____ Other: _____

If a flowing well, method of flow regulation: Valve _____ Other (describe): _____

Static Water Level: 31' feet above or below (circle one) land surface Date measured: 6-7-07

Method of Measurement (circle one) steel tape electric tape air line other: _____

Well depth: 70' Well grouted to a depth of 10' feet Type of grout (circle one): Neat Cement Bentonite Mix

Casing length: 50' feet Casing diameter: 4" inches Type of casing: Pvc

Screen length: 20' feet Screen diameter: 4" inches Type of screen: Pvc

Screen slot size: 012/010 inches Setting depth: From 50' feet to 70' feet

Type of completion (circle all applicable): Gravel packed Underreamed Telescoped Open hole Natural Development
Other (describe): _____

Top of lap pipe or reduction in casing: _____ feet *If telescoped or more than one screen, describe on next page*

Form: OLWR-SWR-1A

Customer going to set pump & Has a copy of Part 2

RECEIVED
JUN 19 2007
BY: OLWR

The sketch below only required for water wells

If well telescopes, they don't on sketch.


Ground Level _____

Description of formations encountered must be provided for all wells and boreholes, unless specifically exempted by regulations

[illegible]

If more than one screen, show location of each on sketch

Sketch the property layout and include the following: 1) the well location; 2) any permanent structures on the property that may aid in locating the well; 3) any roads, power lines, or other items that may aid in locating the property and the well; 4) a north arrow.

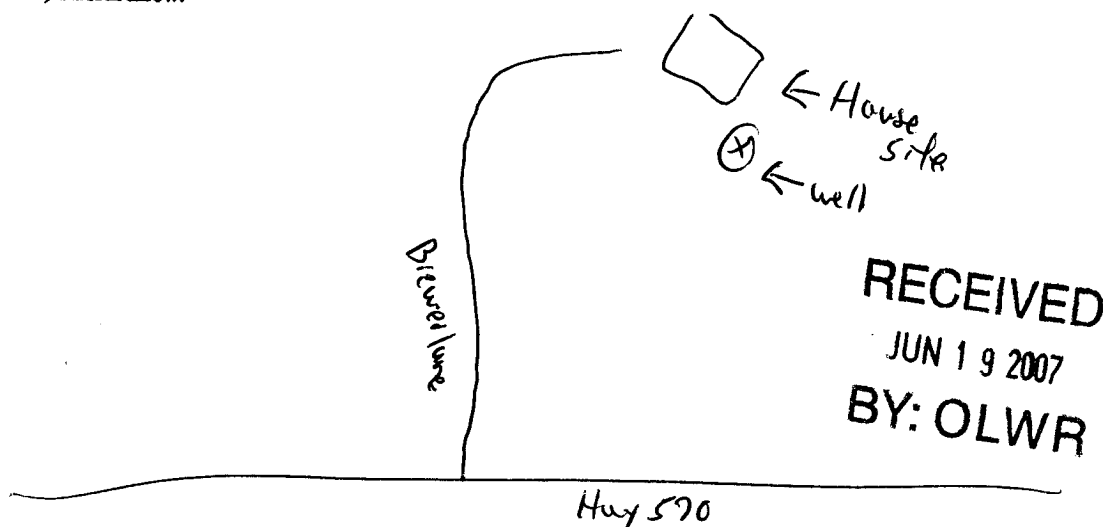

Landowner Name: _____

Form: OLWR-SWR-1A

I certify that the well/borehole was drilled, constructed, and completed in accordance with all applicable requirements of the Mississippi Department of Environmental Quality and the Mississippi Department of Health regulations, if applicable, and state laws.

Brad Fitzgerald 029 6-7-07. Brad Fitzgerald
Print Name of Responsible Licensee and License No. Date Signature of Licensee