	State Y		B215	
County: Pike		Vell Report Driller's Log	For Office Use Only:	
Permit #:	Mississippi Departme	ent of Environmental Quality	Aquifer: Miocene	
Driller: Smce	P.O	and Water Resources . Box 2309	Well #: _ E (Brobett =	
Date drilling completed: 2-18-97	Jackso (601	Jackson, MS 39225 (601)961- 5210 (601)961- 5228 (fax)		
State Law requires that this repo	L It he prepared by the 1		E-log #:	
State Law requires that this repo Department at the above addres Information on Well	s within 30 days of com	cense holder responsible for t pletion of drilling of the well	he work and filed with the	
Information on Well (Landowner if borehole is not j	Owner	Well or Bo	rehole Location	
Owner Name Southwest Com	navity College	Latitude: <u>30 ° 17</u> , 36	" Longitude: <u>91 • 26 • 27</u>	
Mailing Address: College Prin	ve	Method of Lat/Long (circle on	90 e): Conventional Survey,	
		USGS quad, Hand-held	GPS Survey-grade GPS	
<u>Summit</u> City Sta	15 39666	<u>SE 4 SW 4 Sec 19</u>	Twn 4N Rng 7F	
Telephone No. ()	te Zip Code	Distance Direction MilesO	Nearest Town fSummit	
			· · ·	
	Well / Bore	hole Data		
Date drilling started: Febility Date dri	lling completed: 2-18-	97 Hole depth: 185	Hole diameter: 6 inch	
Location of the source of any surface water		1		
	used in drilling and develo	opment: 7 parts per	million	
Logs run (circle all applicable): No log run Name of organization running log(s):		-	ther:	
Purpose of borehole (check one): Water We	□ V Geotechnical/Geolo	gical Investigation Ground S	ource Heat Pump	
Seismic S	urvey Other (describe)			
		skip the remainder of this bloc		
	ustrial Public Supply_	IrrigationFish Culture	_Other:	
If a flowing well, method of flow regulation	: Valve Oth	er (describe)		
Static Water Level: 55' feet abo	ve orbelow (circle one) lar	nd surface Date measured:	- 18 - 97	
Method of Measurement (circle one) stee	el tape electric tape	air line other: <u>50 n</u>		
Well depth: 185 Well grouted to a dept	h of 165 feet Time	f grout (airel-		
Casing length: 165 feet Casing	diameter:			
Screen length: 20		· · · · ·		
Screen length: <u>20</u> feet Screen				
Screen slot size: .012 inches		185 feet to 14.5	feet	
Type of completion (circle all applicable):	Gravel packed Underrea	med Telescoped Open hol		
	Other (describe):		- manara Development	
Top of lap pipe or reduction in casing:	reet. <u>If telesc</u>	coped or more than one screen, o	lescribe on next page	
			Form: OLWR-SWR-1A (04/08	
			RECEIV	
			FEB 0 4 20	
			BY: OLW	

215


The sketch below only required for water wells

If well telescopes, show dept Ground Level		
•		
ł		

Description of formations encountered must be provided for all wells and boreholes, unless specifically exempted by regulations

Description of Formations Encountered	From (depth)	Го (depth)
Surface Soil	Ground Level	20
course to Med. Sand	80	70
Grave	70	100
White Clay	100	165
Course Sand	165	185
	· · · · · · · · · · · · · · · · · · ·	
		·
· · · · · · · · · · · · · · · · · · ·	+	
· · · · · · · · · · · · · · · · · · ·		
	•	
	+	

If more than one screen, show location of each on sketch

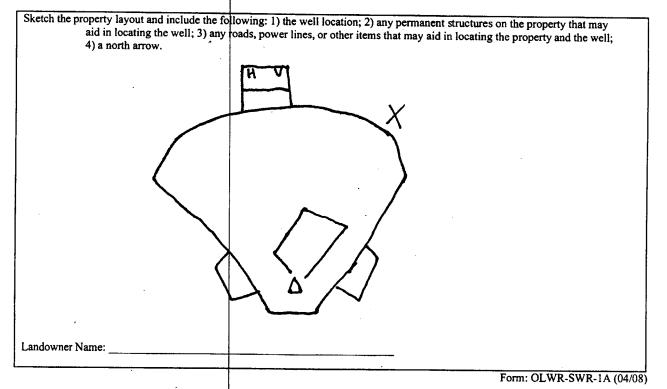

I certify that the well/borehole was drilled, constructed, and completed in accordance with all applicable requirements of the Mississippi Department of Environmental Quality and the Mississippi Department of Health regulations, if applicable, and state laws.

Joe Juneau 0516

Print Name of Responsible Licensee and License No.

Date

Signature of Licensee

FEB 0 4 2009 **BY: OLWR**

RECEIVED

			B215
County: P:Ke Permit #: Driller: SMCC Date completed: 2-18-97 Copy information from block on Part 1 This part of the report must be completed	STATE WELL REPORT Part 2 Pump Installer's Completion Report Mississippi Department of Environmental Quality Office of Land and Water Resources P.O. Box 2309 Jackson, MS 39225 (601)961-5210 (601)961-5228 (fax)		For Office Use Only: Aquifer: Miocene Well #: 5 Elevation: 445
report must be attached and both parts fil Well Owner Informat Owner Name: <u>SMCC</u> Mailing Address: <u>College</u> Drive	ed with the Department a ion	t the above address within 3 Latitude: <u>30°</u> 31-17 Method of Lat/Long (chec	
Summ: + MS City State	39666 Zip Code	<u>SE</u> ½ <u>SW</u> ½ Sec_ Distance Directio	19 T 4NR 788E
Pump Type Circle one	Submersible	Discol Engine Ga	Power Type Circle one
Air Lift Jet Bucket Piston	Submersible Turbine	Electric Motor Ha	
Centrifugal Rotary Other (specify):	Flowing Well Gallons Per Minute		1 .
	Below Land Surface Below Land Surface	Air Line Electric	Measuring Water Level Circle one Measuring Line Steel Tape
	Below Land Surface Gallons Per Minute	Well yielded 135	ed shut in head:feet GPM with a drawdown of er 24 hours of pumping
I HEREBY CERTIFY that the above stater Print Name of Pump Installer and License		of my knowledge. Signature of Purr	Form: OLWR-SWR-1B (04/08)
			RECEI FEB 0 4 BY: OL

* • • • • •