

Pike  
 B 2002  
 9-27-76

MISSISSIPPI  
 BOARD OF WATER COMMISSIONERS  
 416 North State Street  
 Jackson, Mississippi 39201

1321

WATER WELL DRILLERS LOG

Sept 27 1976 *Rever Miller* *Pike*  
 date well completed firm name county well located

LANDOWNER:  
*Ralph Felder Jr -*  
*Pt Summit*  
 (mailing address)

description of formations encountered	from	to
<i>red clay</i>	<i>0</i>	<i>12</i>
<i>red sand</i>	<i>12</i>	<i>30</i>
<i>Chalky sand &amp; gravel</i>	<i>30</i>	<i>80</i>
<i>pink chalk</i>	<i>80</i>	<i>95</i>
<i>fine gravel &amp; sand</i>	<i>95</i>	<i>93</i>

WELL LOCATION:  
 sec. *9* T. *4* N R. *8* E  
*4* miles *E-NE* of *Summit*  
 (distance) (direction) (nearest town)

WELL PURPOSE: *home*  
 (home, irrigation, municipal, industrial)

- WELL COMPLETION DATA:
- (1) diameter (inches) *4"*
  - (2) total depth (feet) *93*
  - (3) static water level (feet) *35* below top of ground.
  - (4) casing *plastic bottom*  
 (material) (depth)
  - 1/2"* If telescope see back.  
 (size)
  - (5) screen *6'* *87*  
 (length) (depth to top)
  - 4"* *plastic*  
 (size) (material)
  - (6) pump *1/2* *1.0*  
 (HP) (yield gpm)
  - elect*  
 (type power)
  - (7) electric log *no*  
 (yes or no)
  - no*  
 (organization running log)

(8) how well bottom plugged  
*wooden plug*

DRILLERS REMARKS:  
*other well hit by lightning*


RECEIVED

DEC 8 1976

MISSISSIPPI WATER COMMISSION

If well telescopes please sketch and show depths.

GROUND LEVEL

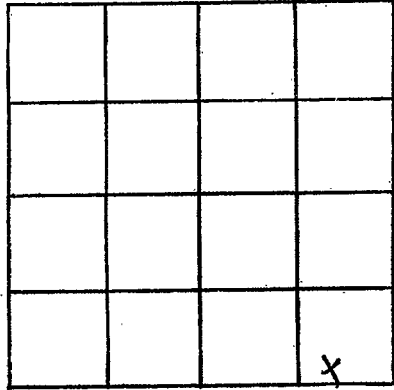

SECTION 9

Please indicate well location X.

ADDITIONAL INFORMATION

If more than one screen, show locations of each on sketch.