

Pike  
 B 2003  
 9/6/76

MISSISSIPPI  
 BOARD OF WATER COMMISSIONERS  
 416 North State Street  
 Jackson, Mississippi 39201

WATER WELL DRILLERS LOG

10 Sept 1976  
 date well completed

132A

J. T. Carrington  
 firm name

Pike  
 county well located

LANDOWNER:

Hilton Washington

Summit  
 (mailing address)

WELL LOCATION:

sec. 2 T 4 N R 8 E  
 10 miles NE of Summit  
 (distance) (direction) (nearest town)

WELL PURPOSE:

(home, irrigation, municipal, industrial)

WELL COMPLETION DATA:

- (1) diameter (inches) 4
- (2) total depth (feet) 114
- (3) static water level (feet) 80 below top of ground.
- (4) casing PL, 108 (material) (depth)
- (size) if telescope see back.
- (5) screen 6, 108 (length) (depth to top)
- 4, PL (size) (material)
- (6) pump 1/2, 8 (HP) (yield gpm)
- (type power)
- (7) electric log (yes or no)
- (organization running log)
- (8) how well bottom plugged

description of formations encountered

from to

description of formations encountered	from	to
Clay	0	20
Cherty	20	45
Sand	45	70
Silt	70	90
Sand	90	114

DRILLERS REMARKS:

used air pump


RECEIVED

OCT 29 1976

MISS. BD. OF WATER

If well telescopes please sketch and show depths.

GROUND LEVEL

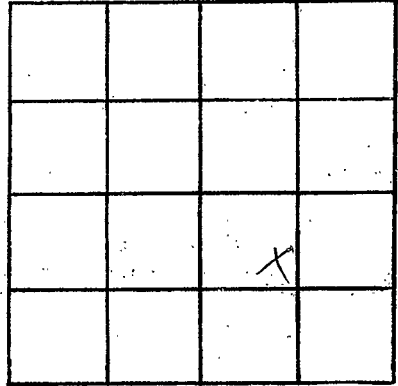

SECTION 10

Please indicate well location X.

ADDITIONAL INFORMATION

If more than one screen, show locations of each on sketch.