

Pike
 13 2004
 1-24-77

MISSISSIPPI
 BOARD OF WATER COMMISSIONERS
 416 North State Street
 Jackson, Mississippi 39201

6

WATER WELL DRILLERS LOG

Jan-24 1977 Reverwell Inc Pike
 date well completed firm name county well located

LANDOWNER:
Mr. Carl Hudson
Rt Summit
 (mailing address)

description of formations encountered from to

WELL LOCATION:
 sec. 7 T 4 N R 8 E
2 1/2 miles west of Summit
 (distance) (direction) (nearest town)

Pulled steel pipe

WELL PURPOSE: home
 (home, irrigation, municipal, industrial)

installed 4"

WELL COMPLETION DATA:

Plastic

- (1) diameter (inches) 4"
- (2) total depth (feet) 126
- (3) static water level (feet) 55 below top of ground.
- (4) casing plastic bottom
 (material) (depth)

old hole

 if telescope see back.
 (size)

- (5) screen 6' 120'
 (length) (depth to top)
4" plastic
 (size) (material)

- (6) pump 1/2 10
 (HP) (yield gpm)
electric
 (type power)

- (7) electric log no
 (yes or no)

 (organization running log)

- (8) how well bottom plugged
wooden plug


DRILLERS REMARKS:

RECEIVED
 FEB 18 1977

MISS. BD. OF WATER COM.

If well telescopes please sketch and show depths.

GROUND LEVEL

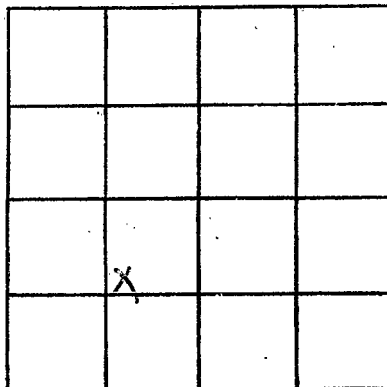

SECTION 7

Please indicate well location X.

ADDITIONAL INFORMATION

If more than one screen, show locations of each on sketch.