

Pike
 Booth
 12/15/77

MISSISSIPPI
 BOARD OF WATER COMMISSIONERS
 416 North State Street
 Jackson, Mississippi 39201

WATER WELL DRILLERS LOG

12-15 1977 Federal Well Serv Pike
 date well completed firm name county well located

LANDOWNER:
Mr. Felder
R.R. Lemmons
 (mailing address)

description of formations encountered	from	to
<u>Red chalk</u>	<u>0</u>	<u>20</u>
<u>Blue chalk</u>	<u>20</u>	<u>70</u>
<u>Crane sand</u>	<u>70</u>	<u>90</u>

WELL LOCATION:
 sec. 25 T-4 N S R-8 E W
8 miles E of Wub
 (distance) (direction) (nearest town)

WELL PURPOSE: Home
 (home, irrigation, municipal, industrial)

- WELL COMPLETION DATA:
- (1) diameter (inches) 4
 - (2) total depth (feet) 90
 - (3) static water level (feet) 35 below top of ground.
 - (4) casing PVC, 82
 (material) (depth)
4 if telescope see back.
 (size)
 - (5) screen 8, 82
 (length) (depth to top)
4, PVC
 (size) (material)
 - (6) pump 1/2, 10
 (HP) (yield gpm)
elec
 (type power)
 - (7) electric log na
 (yes or no)
 (organization running log)
 - (8) how well bottom plugged Seal Slurk


DRILLERS REMARKS:

RECEIVED
 DEC 28 1977

MISS. BOARD OF WATER COMMISSIONERS

If well telescopes please sketch and show depths.

GROUND LEVEL

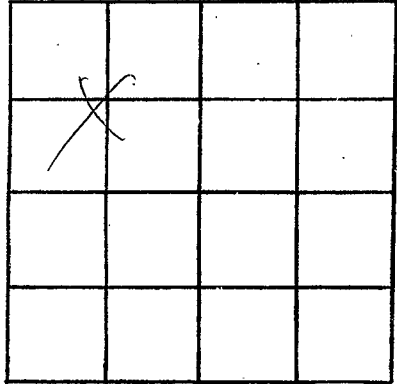

SECTION 25

Please indicate well location X.

ADDITIONAL INFORMATION

If more than one screen, show locations of each on sketch.