

**MISSISSIPPI
BOARD OF WATER COMMISSIONERS**
416 North State Street
Jackson, Mississippi 39201

87

WATER WELL DRILLERS LOG

Pike
B 2008
7/18/77

July 18 1977 Rever Miller Pike
date well completed firm name county well located

LANDOWNER:
James Martin
Rt 1 - Summit
(mailing address)

description of formations encountered	from	to
<u>Red sandy clay</u>	<u>0</u>	<u>30</u>
<u>Red Chalk</u>	<u>30</u>	<u>56</u>
<u>lumpy sand</u>	<u>56</u>	<u>100</u>
<u>sand & pea gravel</u>	<u>100</u>	<u>120</u>

WELL LOCATION:
sec. 13 T. 4 N R. 8 E
7 1/2 miles E-NE of McComb
(distance) (direction) (nearest town)

WELL PURPOSE: Home
(home, irrigation, municipal, industrial)

WELL COMPLETION DATA:

(1) diameter (inches) 4"

(2) total depth (feet) 120

(3) static water level (feet) 100 below above top of ground.

(4) casing plastic bottom
(material) (depth)

7 if telescope see back.
(size)

(5) screen 5' 115'
(length) (depth to top)

4" plastic
(size) (material)

(6) pump 1/2 10
(HP) (yield gpm)

elect
(type power)

(7) electric log no
(yes or no)

Woods
(organization running log)

(8) how well bottom plugged:
Woods plug


DRILLERS REMARKS:

RECEIVED
DEC 29 1977

MISS. BD. OF WATER COMMISSIONERS

If well telescopes please sketch and show depths.

GROUND LEVEL

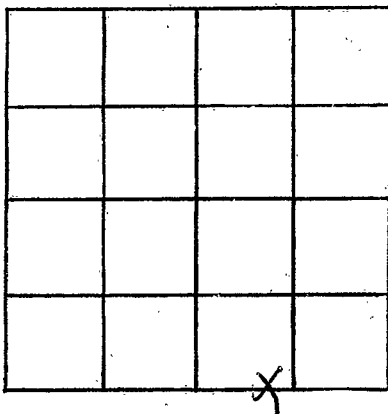

SECTION 13

Please indicate well location X.

ADDITIONAL INFORMATION

Lined area for additional information.

If more than one screen, show locations of each on sketch.