

PIKE  
 B 2009  
 0-27-78

MISSISSIPPI  
 BOARD OF WATER COMMISSIONERS  
 416 North State Street  
 Jackson, Mississippi 39201

WATER WELL DRILLERS LOG

9-27-78 date well completed  
 1978 firm name  
 Pike county well located

LANDOWNER:  
 Mark Statham  
 P.O. Summit MS  
 (mailing address)

description of formations encountered	from	to
Red clay	0	20
white & blue chert	20	85
fine sand	80	105
course sand & gravel	105	114

WELL LOCATION:  
 sec. 24 T 4 N R 8 E  
 S W  
 8 miles E of MCB  
 (distance) (direction) (nearest town)

WELL PURPOSE: Home  
 (home, irrigation, municipal, industrial)

WELL COMPLETION DATA:

(1) diameter (inches) 4

(2) total depth (feet) 114

(3) static water level (feet) 48 below top of ground.

(4) casing PVC 106  
 (material) (depth)  
 If telescope see back.

(5) screen 8 106  
 (length) (depth to top)  
 4 PVC  
 (size) (material)

(6) pump 1/2 10  
 (HP) (yield gpm)  
 elec  
 (type power)

(7) electric log yes or no

(organization running log)

(8) how well bottom plugged


RECEIVED  
 OCT 4 1978

DRILLERS REMARKS:

MISS. Bd. OF WATER COMM.

If well telescopes please sketch and show depths.

GROUND LEVEL

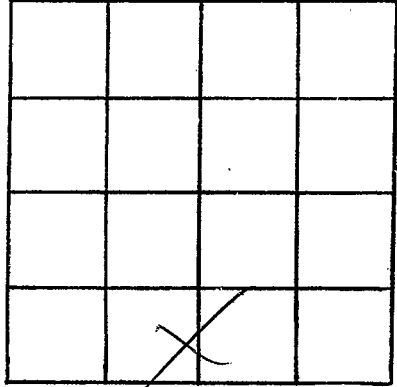

SECTION 2f

Please indicate well location X.

ADDITIONAL INFORMATION

A series of horizontal lines for writing additional information.

If more than one screen, show locations of each on sketch.