

PIKE

B 2010

7-9-78

MISSISSIPPI BOARD OF WATER COMMISSIONERS 416 North State Street Jackson, Mississippi 39201

WATER WELL DRILLERS LOG

July 9 1978 Revere Well Ser. Pike date well completed firm name county well located

LANDOWNER: Hollis Patterson #3 McComb (mailing address)


WELL LOCATION: sec. 13 T. 4 N R. 8 E 2 1/2 miles West of Felda Camp (distance) (direction) (nearest town)

WELL PURPOSE: home (home, irrigation, municipal, industrial)

WELL COMPLETION DATA: (1) diameter (inches) 4" (2) total depth (feet) 140 (3) static water level (feet) 87 below top of ground. (4) casing plastic bottom (material) (depth) (5) screen 5" 135" (length) (depth to top) 4" plastic (size) (material) (6) pump 10 (HP) (yield gpm) elect (type power) (7) electric log no (yes or no) (organization running log)

(8) how well bottom plugged W. B. ... DRILLERS REMARKS:


Table with 3 columns: description of formations encountered, from, to. Rows include: Red Clay (2-27), Red sand (27-80), Gravel & sand (80-93), Fine pink sand (93-126), Gravel & sand (126-140).

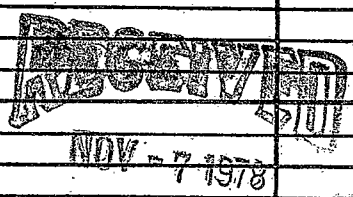

MISS. BD. OF WATER COMMISSIONERS

If well telescopes please sketch and show depths.

GROUND LEVEL

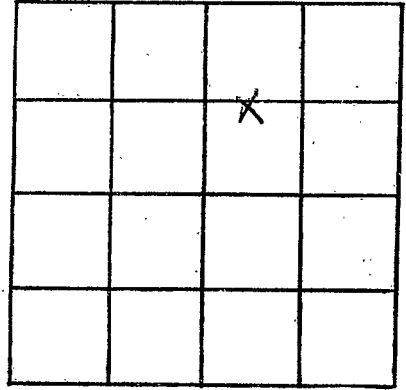

SECTION 13

Please indicate well location X.

ADDITIONAL INFORMATION

If more than one screen, show locations of each on sketch.