

PIKE
B 2001
10-26-78

MISSISSIPPI
BOARD OF WATER COMMISSIONERS
416 North State Street
Jackson, Mississippi 39201

WATER WELL DRILLERS LOG

Oct 26 1978 Hennsweiler Pike
 date well completed firm name county well located

LANDOWNER:
J. H. Felder
St Summit
 (mailing address)

description of formations encountered	from	to
<u>gravel & clay</u>	<u>2</u>	<u>27</u>
<u>gravel & sand</u>	<u>27</u>	<u>65</u>
<u>Red sand & clay</u>	<u>65</u>	<u>105</u>
<u>sand & gravel</u>	<u>105</u>	<u>117</u>

WELL LOCATION:
 sec. 13 T 4 N R 8 E
7 miles E-NE of Summit
 (distance) (direction) (nearest town)

WELL PURPOSE: Drinking
 (home, irrigation, municipal, industrial)

WELL COMPLETION DATA:

(1) diameter (inches) 4"

(2) total depth (feet) 117

(3) static water level (feet) 75 above top of ground.

(4) casing plastic bottom
 (material) (depth)

— if telescope see back.
 (size)

(5) screen 2" 112'
 (length) (depth to top)

4" plastic
 (size) (material)

(6) pump 1/2 HP 6
 (HP) (yield gpm)

split
 (type power)

(7) electric log no
 (yes or no)

—
 (organization running log)

(8) how well bottom plugged
Wooden plug

DRILLERS REMARKS:
old well hit by lightning


Miss. Board of Water Comm.

FEB 15 1979

RECEIVED

If well telescopes please sketch and show depths.

GROUND LEVEL

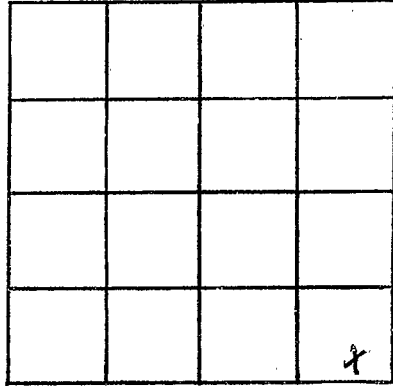

SECTION 13

Please indicate well location X.

ADDITIONAL INFORMATION

If more than one screen,
show locations of each on sketch.