

PIKE

B 2012

12-20-78

MISSISSIPPI
 BOARD OF WATER COMMISSIONERS
 416 North State Street
 Jackson, Mississippi 39201

WATER WELL DRILLERS LOG

12-20 1978
date well completed

Fitzgerald Well Sew
firm name

Pike
county well located

LANDOWNER:

Joe Brown

R.R. Summit, ms.
(mailing address)

WELL LOCATION:

sec. 10 T 4 N R 8 E
 S W
 7 miles W of Summit
 (distance) (direction) (nearest town)

WELL PURPOSE: Home
 (home, irrigation, municipal, industrial)

WELL COMPLETION DATA:

- (1) diameter (inches) 2
- (2) total depth (feet) 405
- (3) static water level (feet) 150 below above top of ground.
- (4) casing Galvanized 399, (material) (depth)
- 2 (size) if telescope see back.
- (5) screen 6, 399 (length) (depth to top)
- 2" Stainless Steel (size) (material)
- (6) pump 2 10 (HP) (yield gpm)
- Electric (type power)
- (7) electric log No (yes or no)
- (organization running log)
- (8) how well bottom plugged Sand Seal

description of formations encountered

from to

Red clay	0	20
Red sand	20	85
Coarse sand & gravel	85	114
Blue chalk	114	260
Fine sand	260	275
Blue chalk & shale	275	390
Coarse sand & gravel	390	405

DRILLERS REMARKS:


RECEIVED
RIS

JAN 26 1978

MISS. BD. OF WATER COMM

If well telescopes please sketch and show depths.

GROUND LEVEL

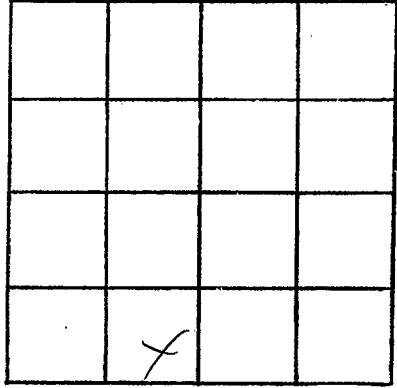

SECTION 10

Please indicate well location X.

ADDITIONAL INFORMATION

A series of horizontal lines for writing additional information.

If more than one screen, show locations of each on sketch.