

PIKE
B 2014
01-31-79

**MISSISSIPPI
BOARD OF WATER COMMISSIONERS**
416 North State Street
Jackson, Mississippi 39201

WATER WELL DRILLERS LOG

Jan 31 1979 Reuss Miller Pike
 date well completed firm name county well located

LANDOWNER:
Bill Jones
Rt Summit
 (mailing address)

description of formations encountered	from	to
	<u>fine clay</u>	<u>0</u>
<u>chalk sand & gravel</u>	<u>17</u>	<u>30</u>
<u>lobbly sand</u>	<u>30</u>	<u>95</u>
<u>coarse sand & small gravel</u>	<u>95</u>	<u>110</u>

WELL LOCATION:
 sec. 5 T. 4 N. R. 8 E
5 miles N-NE of Summit
 (distance) (direction) (nearest town)

WELL PURPOSE: home
 (home, irrigation, municipal, industrial)

WELL COMPLETION DATA:

(1) diameter (inches) 4"

(2) total depth (feet) 110

(3) static water level (feet) 53 below top of ground.

(4) casing plastic bottom
 (material) (depth)

 if telescope see back.
 (size)

(5) screen 5' 105'
 (length) (depth to top)

4" plastic
 (size) (material)

(6) pump hercules
 (HP) (yield gpm)

cbt
 (type power)

(7) electric log no
 (yes or no)

 (organization running log)

(8) how well bottom plugged wooden plug

DRILLERS REMARKS:


Miss. Board of Water Comm.

APR 26 1979

RECEIVED

If well telescopes please sketch and show depths.

GROUND LEVEL

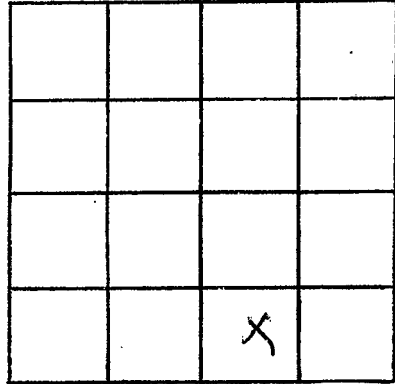

SECTION 57

Please indicate well location X.

ADDITIONAL INFORMATION

If more than one screen,
show locations of each on sketch.