

Pike
 Boone
 3-2-79

MISSISSIPPI
 BOARD OF WATER COMMISSIONERS
 416 North State Street
 Jackson, Mississippi 39201

WATER WELL DRILLERS LOG

3-2
 date well completed

19 79 *Getwell Drilling*
 firm name

Pike
 county well located

LANDOWNER:
Burl Harris
R.R. Smith
 (mailing address)

description of formations encountered	from	to
	<i>Red clay</i>	<i>0</i>
<i>Red sand</i>	<i>20</i>	<i>60</i>
<i>White chalk</i>	<i>60</i>	<i>120</i>
<i>mass. sand & gravel</i>	<i>120</i>	<i>131</i>

WELL LOCATION:
 sec. *5* T. *4* N. R. *2* E
7 miles *ENE* of *Smith*
 (distance) (direction) (nearest town)

WELL PURPOSE:
 (home, irrigation, municipal, industrial)

- WELL COMPLETION DATA:
- (1) diameter (inches) *4*
 - (2) total depth (feet) *131*
 - (3) static water level (feet) *80* below above top of ground.
 - (4) casing *4" PVC 123*
 (material) (depth)
4 (size) if telescope see back.
 - (5) screen *8" 123*
 (length) (depth to top)
4" PVC
 (size) (material)
 - (6) pump *1/2 10*
 (HP) (yield gpm)
Electric
 (type power)
 - (7) electric log *no*
 (yes or no)
 - (8) how well bottom plugged *Red clay*
 (organization running log)

Miss. Board of Water Comm.


MAR 28 1979

DRILLERS REMARKS:

DRILLER'S SIGNATURE

If well telescopes please sketch and show depths.

GROUND LEVEL

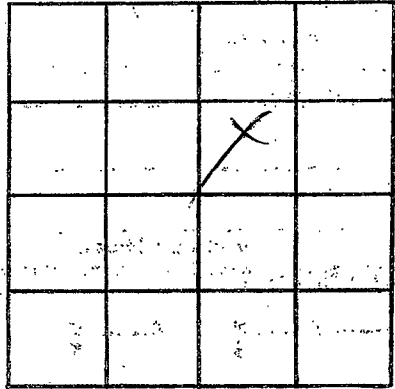

SECTION

5

Please indicate well location X:

ADDITIONAL INFORMATION

If more than one screen, show locations of each on sketch.