

712a
B 2017
May 18, 1979

MISSISSIPPI
 BOARD OF WATER COMMISSIONERS
 416 North State Street
 Jackson, Mississippi 39201

WATER WELL DRILLERS LOG

5-18 19 79 Fitzgerald Well Service 712a
 date well completed firm name county well located

LANDOWNER:
Sensine Young
R.B. Summit
 (mailing address)

description of formations encountered	from	to
<u>Red Clay</u>	<u>0</u>	<u>20</u>
<u>Red + White chert</u>	<u>20</u>	<u>72</u>
<u>Quartz sandstone</u>	<u>72</u>	<u>80</u>

WELL LOCATION:
 sec. 30 T. 4 N. R. 8 E.
1 miles E of Summit
 (distance) (direction) (nearest town)

WELL PURPOSE: Home
 (home, irrigation, municipal, industrial)

- WELL COMPLETION DATA:
- (1) diameter (inches) 4
 - (2) total depth (feet) 80
 - (3) static water level (feet) 60 below above top of ground.
 - (4) casing PVC 72
 (material) (depth)
4 if telescope see back.
 (size)
 - (5) screen 8 72
 (length) (depth to top)
4 PVC
 (size) (material)
 - (6) pump 1/2 10
 (HP) (yield gpm)
Elco
 (type power)
 - (7) electric log no
 (yes or no)
 (organization running log)
 - (8) how well bottom plugged Level Shd

Miss. Board of Water Comm.


JUL 17 1979

RECEIVED

DRILLERS REMARKS:

If well telescopes please sketch and show depths.

GROUND LEVEL

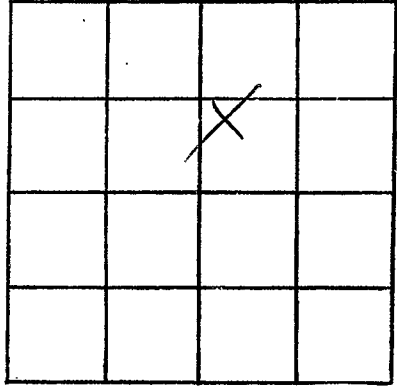

SECTION _____

Please indicate well location X.

ADDITIONAL INFORMATION

Lined area for additional information.

If more than one screen, show locations of each on sketch.