

RIKE  
B 2018  
May 22, 1979

MISSISSIPPI  
 BOARD OF WATER COMMISSIONERS  
 416 North State Street  
 Jackson, Mississippi 39201

WATER WELL DRILLERS LOG

5-22 19 79 Fitzmaurice Inc Rike  
 date well completed firm name county well located

LANDOWNER:  
Roy Morgan  
R.B. Baze Chitto  
 (mailing address)

description of formations encountered	from	to
<u>Reel clay</u>	<u>0</u>	<u>20</u>
<u>Reel sand shale</u>	<u>20</u>	<u>80</u>
<u>Coarse sand gravel</u>	<u>80</u>	<u>92</u>

WELL LOCATION:  
 sec. 1 T 7 N R 8 E  
4 miles sw of Reith  
 (distance) (direction) (nearest town)


WELL PURPOSE: flow  
 (home, irrigation, municipal, industrial)

- WELL COMPLETION DATA:
- (1) diameter (inches) 4
  - (2) total depth (feet) 92
  - (3) static water level (feet) 20 below top of ground.
  - (4) casing PVC, 84,  
 (material) (depth)  
4 if telescope see back.  
 (size)
  - (5) screen 8, 84  
 (length) (depth to top)  
4, PVC  
 (size) (material)
  - (6) pump 1/2, 10  
 (HP) (yield gpm)  
ela  
 (type power)
  - (7) electric log no  
 (yes or no)  
 (organization running log)
  - (8) how well bottom plugged Sealed

DRILLERS REMARKS:

If well telescopes please sketch and show depths.

GROUND LEVEL

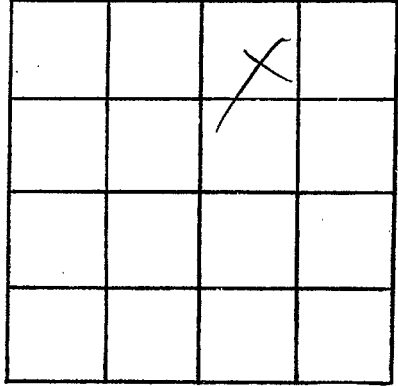

SECTION   /  

Please indicate well location X.

ADDITIONAL INFORMATION

Lined area for additional information.

Miss. Board of Water Comm.

JUL 17 1979

If more than one screen, show locations of each on sketch.

RECEIVED