

PIKE
 B 2019
 5-18-79

MISSISSIPPI
 BOARD OF WATER COMMISSIONERS
 416 North State Street
 Jackson, Mississippi 39201

WATER WELL DRILLERS LOG

5-18 date well completed 1979 Fitzmaurice Well Serv firm name Pike county well located

LANDOWNER:
Janie Finch
Bib. Summit (mailing address)

description of formations encountered	from to	
	feet	feet
Red clay	0	20
White cloth	20	75
Course sandstone	75	85

WELL LOCATION:
 sec. 30 T-4 N R-8 E
1 miles E of Summit
 (distance) (direction) (nearest town)

WELL PURPOSE:
Home
 (home, irrigation, municipal, industrial)


- WELL COMPLETION DATA:
- (1) diameter (inches) 4
 - (2) total depth (feet) 85
 - (3) static water level (feet) 60 below top of ground.
 - (4) casing 4 (material) 77 (depth)
4 if telescope see back. (size)
 - (5) screen 8 (length) 77 (depth to top)
4 (size) ps (material)
 - (6) pump 1/2 (HP) 10 (yield gpm)
Ele (type power)
 - (7) electric log Yes (yes or no)
(organization running log)
 - (8) how well bottom plugged Full

DRILLERS REMARKS:

Miss. Board of Water Comm.
 JUL 17 1979
RECEIVED

If well telescopes please sketch and show depths.

GROUND LEVEL

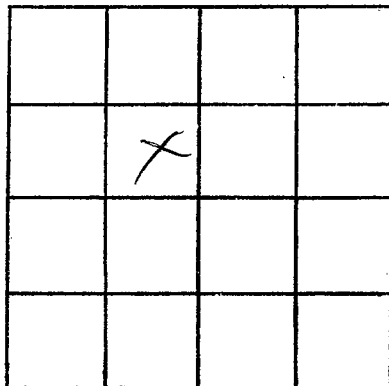

SECTION 30

Please indicate well location X.

ADDITIONAL INFORMATION

If more than one screen, show locations of each on sketch.