

PIKE
 B 2020
 3/27/79

MISSISSIPPI
 BOARD OF WATER COMMISSIONERS
 416 North State Street
 Jackson, Mississippi 39201

WATER WELL DRILLERS LOG

March 27 19 Reens Miller Pike
 date well completed firm name county well located

LANDOWNER:
Bobby Scott
Rt 5 - McComb
 (mailing address)

description of formations encountered	from	to
<u>Red sandstone</u>	<u>0</u>	<u>30</u>
<u>Red siltstone</u>	<u>30</u>	<u>50</u>
<u>Sand & gravel</u>	<u>50</u>	<u>75</u>
<u>Chalky gravel</u>	<u>75</u>	<u>83</u>
<u>hard sand rock</u>	<u>83</u>	<u>85</u>
<u>sand & gravel</u>	<u>85</u>	<u>104</u>

WELL LOCATION:
 sec. 10 T-4 N R-8 E
3 1/2 miles East of McComb
 (distance) (direction) (nearest town)

WELL PURPOSE: home
 (home, irrigation, municipal, industrial)

WELL COMPLETION DATA:
 (1) diameter (inches) 4"
 (2) total depth (feet) 104
 (3) static water level (feet) 62 below above top of ground.
 (4) casing plastic bottom
 (material) (depth)
 (size) if telescope see back.
 (5) screen 10' 94'
 (length) (depth to top)
4" plastic
 (size) (material)
 (6) pump 3 hp 15'
 (HP) (yield gpm)
electric
 (type power)
 (7) electric log no
 (yes or no)
 (organization running log)

(8) how well bottom plugged:
wood plug
 DRILLERS REMARKS:
no remarks

Miss. Board of Water Comm


AUG 24 1979

RECEIVED

If well telescopes please sketch and show depths.

GROUND LEVEL

Handwritten notes and sketches on the left side of the page, including vertical lines and illegible text.

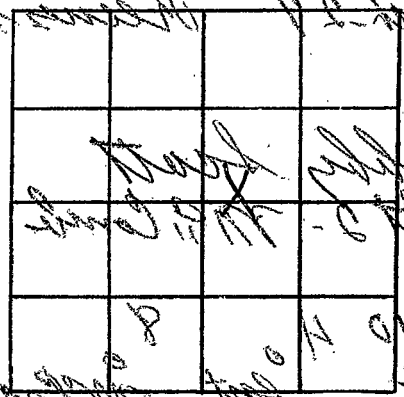

SECTION _____

Please indicate well location X.

ADDITIONAL INFORMATION

Multiple horizontal lines for additional information, with handwritten notes and numbers such as '10', '11', '12', '49', '50'.

If more than one screen, show locations of each on sketch.

Handwritten notes at the bottom right of the page.