

Pike  
B

MISSISSIPPI  
BOARD OF WATER COMMISSIONERS  
416 North State Street  
Jackson, Mississippi 39201

4-25-79

WATER WELL DRILLERS LOG

April 25 1979  
date well completed

Reuss Wellser  
firm name

Pike  
county well located

LANDOWNER:	description of formations encountered	from	to
Dalarius Coon Rt 1 Summit (mailing address)			
WELL LOCATION:			
sec. 30 T 4 N R 8 E 1 1/2 miles east of Summit (distance) (direction) (nearest town)			
WELL PURPOSE: home (home, irrigation, municipal, industrial)			
WELL COMPLETION DATA:			
(1) diameter (inches) 4"			
(2) total depth (feet) 90'			
(3) static water level (feet) 50' below top of ground.			
(4) casing plastic bottom (material) (depth)			
(5) screen 5' 85' (length) (depth to top)			
(6) pump 4" plastic (size) (material)			
(6) pump 1/2 HP 10 (HP) (yield gpm)			
(7) electric log no (yes or no)			
(8) how well bottom plugged mud plug			
DRILLERS REMARKS:			


DEPT. OF NATURAL RESOURCES  
BUREAU OF LAND & WATER RESOURCES

OCT 19 1979

RECEIVED

If well telescopes please  
sketch and show depths.

GROUND LEVEL

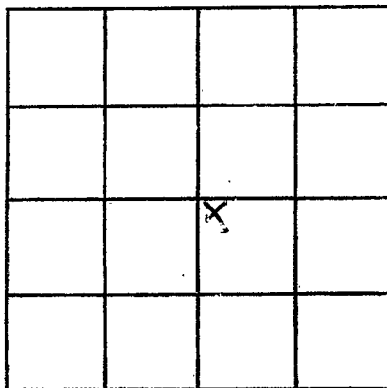

SECTION 30

Please indicate well location X.

ADDITIONAL INFORMATION

If more than one screen,  
show locations of each on sketch.