

Pike
 6
 2023
 10-30-79

MISSISSIPPI
 BOARD OF WATER COMMISSIONERS
 416 North State Street
 Jackson, Mississippi 39201

WATER WELL DRILLERS LOG

10-30 date well completed 19 79 firm name *F. H. Smallwell, Inc.* Pike county well located

LANDOWNER:
Pete Poelzel
R.B. McComb
 (mailing address)

description of formations encountered	from	to
<i>Red clay</i>	<i>0</i>	<i>20</i>
<i>Red sand</i>	<i>20</i>	<i>70</i>
<i>White clay</i>	<i>70</i>	<i>160</i>
<i>Coarse sand & gravel</i>	<i>160</i>	<i>172</i>

WELL LOCATION:
 sec. *24* T. *4* N. R. *8* E.
 S W
3 miles *W* of *Felchus*
 (distance) (direction) (nearest town)

WELL PURPOSE: *Home*
 (home, irrigation, municipal, industrial)

- WELL COMPLETION DATA:
- (1) diameter (inches) *4*
 - (2) total depth (feet) *172*
 - (3) static water level (feet) *110* above top of ground.
 - (4) casing *MVC*, *164*,
 (material) (depth)
4 if telescope see back.
 (size)
 - (5) screen *8*, *164*
 (length) (depth to top)
4, *MVC*
 (size) (material)
 - (6) pump *1*, *18*
 (HP) (yield gpm)
elec
 (type power)
 - (7) electric log *no*
 (yes or no)
 - (organization running log)
 - (8) how well bottom plugged *Sand plug*

DRILLERS REMARKS:


DEPT. OF NATURAL RESOURCES
 BUREAU OF LAND & WATER RESOURCES

NOV - 7 1979

RECEIVED

If well telescopes please sketch and show depths.

GROUND LEVEL

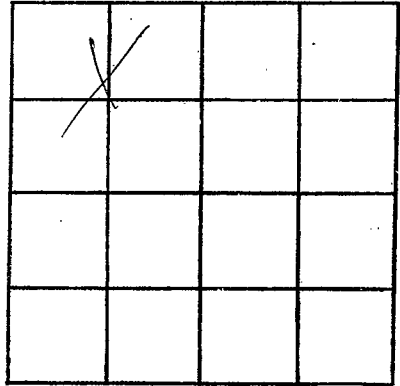

SECTION 34

Please indicate well location X.

ADDITIONAL INFORMATION

Lined area for additional information.

If more than one screen, show locations of each on sketch.