

MISSISSIPPI DEPARTMENT OF NATURAL RESOURCES
 Bureau of Land and Water Resources
 Southport Mall
 P.O. Box 10631
 Jackson, Mississippi 39209
WATER WELL DRILLERS LOG

Pike
B 2024
11-18-80

Nov 18 1980 Reiner Miller Pipe Pike
 date well completed firm name county well located

LANDOWNER:
David Nunery
Pt Summit
 (mailing address)

description of formations encountered	depth	
	from	to
<u>sandy clay</u>	<u>0</u>	<u>12</u>
<u>hard yellow sand</u>	<u>12</u>	<u>34</u>
<u>fine sand</u>	<u>34</u>	<u>86</u>
<u>clay</u>		
<u>coarse sand</u>	<u>86</u>	<u>96</u>

WELL LOCATION:
 sec. 23 T-4 N R-9 E
4 miles West of Pine Data
 (distance) (direction) (nearest town)

WELL PURPOSE: home
 (home, irrigation, municipal, industrial)

WELL COMPLETION DATA:

(1) diameter (inches) 4"

(2) total depth (feet) 96

(3) static water level (feet) 27 below top of ground.

(4) casing plastic batton
 (material) (depth)

7 if telescope see back.
 (size)

(5) screen 5' 91'
 (length) (depth to top)

4" plastic
 (size) (material)


(6) pump hp others
 (HP) (yield gpm)

shot
 (type power)

(7) electric log no
 (yes or no)

(organization running log)

(8) how well bottom plugged Back Wash valve

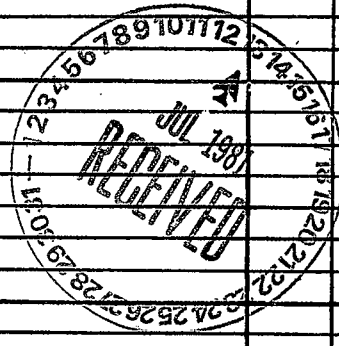

DRILLERS REMARKS:

If well telescopes please sketch and show depths.

GROUND LEVEL

		X	

SECTION 23

Please indicate well location X.

ADDITIONAL INFORMATION

If more than one screen,
show locations of each on sketch.