


PIKE  
B 2050  
7-7-80  
July 7 1980

MISSISSIPPI  
BOARD OF WATER COMMISSIONERS  
416 North State Street  
Jackson, Mississippi 39201

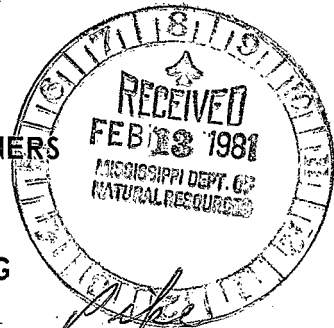

WATER WELL DRILLERS LOG

date well completed: July 7 1980  
firm name: Reeves Well Drilling  
county well located: Pike

LANDOWNER:  
Johnny Gilmore  
Rt 1 Summit  
(mailing address)

description of formations encountered	from	to
clay	0	18
Red sand	18	60
Gravel & sand	60	76
Red Chalk sand	76	90
Small gravel & sand	90	109


WELL LOCATION:  
sec. 10 T 4 N R 8 E  
4 1/2 miles N-NE of Summit  
(distance) (direction) (nearest town)

WELL PURPOSE: hog farm  
(home, irrigation, municipal, industrial)

- WELL COMPLETION DATA:
- (1) diameter (inches) 4"
  - (2) total depth (feet) 109'
  - (3) static water level (feet) 28' below top of ground
  - (4) casing plastic bottom (material) (depth)
  - if telescope see back. (size)
  - (5) screen 5" 104' (length) (depth to top)
  - 1/2" plastic (size) (material)
  - (6) pump 1/2 (HP) 10 (yield gpm)
  - elect (type power)
  - (7) electric log no (yes or no)
  - (organization running log)

(8) how well bottom plugged backwash valve

DRILLERS REMARKS:  
✓

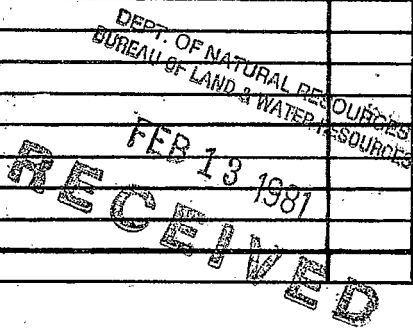

If well telescopes please sketch and show depths.

GROUND LEVEL

X			

SECTION 10

Please indicate well location X.

ADDITIONAL INFORMATION

If more than one screen, show locations of each on sketch.